

USE TYPEWRITER OR BALL POINT PEN—PRESS FIRMLY, PRINT CLEARLY.


WATER WELL RECORD  
KSA 82a-1201-1215

Kansas Department of Health and Environment—Division of Environment  
(Water well Contractors)  
Topeka, Kansas 66620

Billed to: *Whetzel Lumber*

1. Location of well: County *Kingman* Fraction *NW 1/4 SE 1/4* Section number *6* Township number *T 30S S R 5W* Range number *E/W*

2. Distance and direction from nearest town or city: *2 West, 7 North, 1 West*  
Street address of well location if in city:  
3. Owner of well: *Mr. Pullman*  
R.R. or street:  
City, state, zip code: *Harwich, Ks*

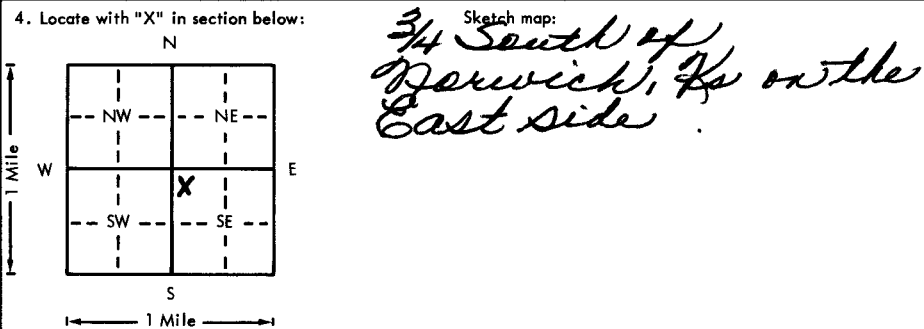

6. Bore hole dia. *11* in. Completion date *8-5-15*  
Well depth *105* ft.  
7.  Cable tool  Rotary  Driven  Dug  
 Hollow rod  Jetted  Bored  Reverse rotary  
8. Use:  Domestic  Public supply  Industry  
 Irrigation  Air conditioning  Stock  
 Lawn  Oil field water  Other  
9. Casing: Material *PVC* Height: *Above* or below  
Threaded  Welded  Surface *12* in.  
RMP  PVC  Weight \_\_\_\_\_ lbs./ft.  
Dia. *5* in. to *105* ft. depth Wall Thickness: inches or  
Dia. \_\_\_\_\_ in. to \_\_\_\_\_ ft. depth gage No. *214*

5. Type and color of material

	From	To
<i>Sandy Soil</i>	<i>0</i>	<i>2</i>
<i>Fine Sand</i>	<i>2</i>	<i>13</i>
<i>Shale</i>	<i>13</i>	<i>105</i>

10. Screen: Manufacturer's name *Get Stream*  
Type *PVC* Dia. *5-11*  
Slot/gauze *.005* Length *85*  
Set between *20* ft. and *105* ft.  
Gravel pack *eye* size range of material *14-18*  
11. Static water level: \_\_\_\_\_ mo./day/yr.  
*15* ft. below land surface Date *8-5-15*  
12. Pumping level below land surfaces:  
\_\_\_\_\_ ft. after \_\_\_\_\_ hrs. pumping \_\_\_\_\_ g.p.m.  
\_\_\_\_\_ ft. after \_\_\_\_\_ hrs. pumping \_\_\_\_\_ g.p.m.  
Estimated maximum yield \_\_\_\_\_ g.p.m.  
13. Water sample submitted: \_\_\_\_\_ mo./day/yr.  
Yes  No  Date \_\_\_\_\_  
14. Well head completion: *Capped*  
 Pitless adapter *12* inches above grade  
15. Well grouted? *eye*  
With:  Neat cement  Bentonite  Concrete  
Depth: From *0* ft. to *10* ft.  
16. Nearest source of possible contamination: *Septic tank*  
ft. *100* Direction *South* Type \_\_\_\_\_  
Well disinfected upon completion?  Yes  No  
17. Pump:  Not installed  
Manufacturer's name *Star Pits*  
Model number *LP6D2* HP *3/4* Volt *230*  
Length of drop pipe *100* ft. capacity *20* g.p.m.  
Type:  Submersible  Turbine  
 Jet  Reciprocating  
 Centrifugal  Other

18. Elevation:  
Topography:  
 Hill  
 Slope  
 Upland  
 Valley  
19. Remarks:  
(Use a second sheet if needed)

20. Water well contractor's certification:  
This well was drilled under my jurisdiction and this report is true to the best of my knowledge and belief.  
*Deep Well Pump 236*  
Business name \_\_\_\_\_ License No. \_\_\_\_\_  
Address *Harwich, Ks.*  
Signed *M. Arnold* Date *8-6-15*  
Authorized representative