WATER WELL RECORD Form WWC-5 KSA 82a-1212

**1 LOCATION OF WATER WELL:** County: Kingman | Fraction: NW ¼ NE ¼ NW ¼ | Section Number: 22 | Township Number: T 30 S | Range Number: R 5 E W

Distance and direction from nearest town or city street address of well if located within city?
2mi. so. ¼ East of Norwich, Kansas

**2 WATER WELL OWNER:** Nancy Fieser
RR#, St. Address, Box # : Norwich, Kansas 67118
City, State, ZIP Code :

Board of Agriculture, Division of Water Resources
Application Number:

**3 LOCATE WELL'S LOCATION WITH AN "X" IN SECTION BOX:**

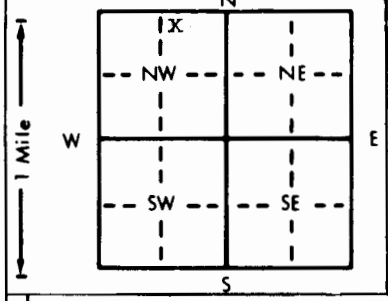


**4 DEPTH OF COMPLETED WELL** 65' ft. ELEVATION:
Depth(s) Groundwater Encountered 1. 21' ft. 2. ft. 3. ft.
WELL'S STATIC WATER LEVEL 20' ft. below land surface measured on mo/day/yr Aug. 16-93
Pump test data: Well water was NA ft. after hours pumping gpm
Est. Yield gpm: Well water was ft. after hours pumping gpm
Bore Hole Diameter 7/8 in. to 26' ft., and 6 3/4" in. to 65' ft.
WELL WATER TO BE USED AS: 5 Public water supply 8 Air conditioning 11 Injection well
XX Domestic 3 Feedlot 6 Oil field water supply 9 Dewatering 12 Other (Specify below)
2 Irrigation 4 Industrial 7 Lawn and garden only 10 Monitoring well
Was a chemical/bacteriological sample submitted to Department? Yes ..... No X ; If yes, mo/day/yr sample was submitted
Water Well Disinfected? Yes XX No

**5 TYPE OF BLANK CASING USED:** 5 Wrought iron 8 Concrete tile CASING JOINTS: Glued X Clamped
1 Steel 3 RMP (SR) 6 Asbestos-Cement 9 Other (specify below) Welded
X 2 PVC 4 ABS 7 Fiberglass Threaded
Blank casing diameter 5" in. to 20 ft., Dia in. to ft., Dia in. to ft.
Casing height above land surface 14" in., weight 160 lbs./ft. Wall thickness or gauge No. SDR 26
TYPE OF SCREEN OR PERFORATION MATERIAL: XX PVC 10 Asbestos-cement
1 Steel 3 Stainless steel 5 Fiberglass 8 RMP (SR) 11 Other (specify)
2 Brass 4 Galvanized steel 6 Concrete tile 9 ABS 12 None used (open hole)
SCREEN OR PERFORATION OPENINGS ARE: 5 Gauzed wrapped XXX 8 Saw cut 11 None (open hole)
1 Continuous slot 3 Mill slot 6 Wire wrapped 9 Drilled holes
2 Louvered shutter 4 Key punched 7 Torch cut 10 Other (specify)
SCREEN-PERFORATED INTERVALS: From 20' ft. to 26' ft., From ft. to ft.
From ft. to ft., From ft. to ft.
GRAVEL PACK INTERVALS: From 26 ft. to 20' ft., From ft. to ft.
From ft. to ft., From ft. to ft.

**6 GROUT MATERIAL:** 1 Neat cement 2 Cement grout XXX 3 Bentonite 4 Other
Grout Intervals: From 20' ft. to 3' ft., From ft. to ft., From ft. to ft.
What is the nearest source of possible contamination: 10 Livestock pens XX 14 Abandoned water well
1 Septic tank 4 Lateral lines 7 Pit privy 11 Fuel storage 15 Oil well/Gas well
2 Sewer lines 5 Cess pool 8 Sewage lagoon 12 Fertilizer storage 16 Other (specify below)
3 Watertight sewer lines 6 Seepage pit 9 Feedyard 13 Insecticide storage
Direction from well? NE How many feet? 75'

| FROM | TO | LITHOLOGIC LOG | FROM | TO | PLUGGING INTERVALS |
|---|---|---|---|---|---|
| 0' | 16' | Top soil & Clay. | | | |
| 16' | 19' | Sandy clay. | | | |
| 19' | 26' | Course sand & fine gravel. | | | |
| 26' | 61' | Red bed - shale. | | | |
| 61' | 65' | Vein- broken red bed. | | | |

**7 CONTRACTOR'S OR LANDOWNER'S CERTIFICATION:** This water well was (1) constructed, (2) reconstructed, or (3) plugged under my jurisdiction and was completed on (mo/day/year) Aug. 16-93 and this record is true to the best of my knowledge and belief. Kansas Water Well Contractor's License No. 112 This Water Well Record was completed on (mo/day/yr) Sept. 14-93
under the business name of Wells Drilling Co. by (signature) Dal Wells

INSTRUCTIONS: Use typewriter or ball point pen. *PLEASE PRESS FIRMLY* and *PRINT* clearly. Please fill in blanks, underline or circle the correct answers. Send top three copies to Kansas Department of Health and Environment, Bureau of Water, Topeka, Kansas 66620-0001. Telephone: 913-296-5545. Send one to WATER WELL OWNER and retain one for your records.

OFFICE USE ONLY T R E/W SEC. ¼ ¼ ¼