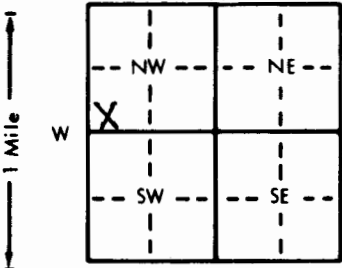


1 LOCATION OF WATER WELL:		Fraction		Section Number		Township Number		Range Number	
County: <u>Kingman</u>		<u>SW 1/4 SW 1/4 NW 1/4</u>		<u>36</u>		T <u>30</u> S		R <u>5</u> <u>EW</u>	
Distance and direction from nearest town or city street address of well if located within city? <u>1 E. 4 1/2 South, Norwich</u>									
2 WATER WELL OWNER: <u>Stan Main</u>									
RR#, St. Address, Box # : <u>Box 43A</u>									
City, State, ZIP Code : <u>Argonia, KS, 67004</u>									
Board of Agriculture, Division of Water Resources Application Number:									
WELL WATER TO BE USED AS: 5 Public water supply 8 Air conditioning 11 Injection well									
1 Domestic 3 Feedlot 6 Oil field water supply 9 Dewatering 12 Other (Specify below)									
2 Irrigation 4 Industrial 7 Lawn and garden only 10 Monitoring well									
Was a chemical/bacteriological sample submitted to Department? Yes <u>X</u> No <u>X</u> ; If yes, mo/day/yr sample was submitted									
Water Well Disinfected? Yes <u>X</u> No									
5 TYPE OF BLANK CASING USED:									
1 Steel 3 RMP (SR) 5 Wrought iron 8 Concrete tile CASING JOINTS: <u>Glued</u> <u>Clamped</u>									
2 PVC 4 ABS 6 Asbestos-Cement 9 Other (specify below) <u>Welded</u>									
7 Fiberglass <u>Threaded</u>									
Casing height above land surface <u>18</u> in., weight <u>18</u> lbs./ft. Wall thickness or gauge No. <u>SOR 26</u>									
TYPE OF SCREEN OR PERFORATION MATERIAL:									
1 Steel 3 Stainless steel 5 Fiberglass 8 RMP (SR) 10 Asbestos-cement									
2 Brass 4 Galvanized steel 6 Concrete tile 9 ABS 11 Other (specify)									
12 None used (open hole)									
SCREEN OR PERFORATION OPENINGS ARE:									
1 Continuous slot 3 Mill slot 5 Gauzed wrapped 8 Saw cut 11 None (open hole)									
2 Louvered shutter 4 Key punched 6 Wire wrapped 9 Drilled holes									
7 Torch cut 10 Other (specify)									
6 GROUT MATERIAL: 1 Neat cement 2 Cement grout 3 Bentonite 4 Other <u>Sand-Hole Plug</u>									
What is the nearest source of possible contamination:									
1 Septic tank 4 Lateral lines 7 Pit privy 10 Livestock pens 14 Abandoned water well									
2 Sewer lines 5 Cess pool 8 Sewage lagoon 11 Fuel storage 15 Oil well/Gas well									
3 Watertight sewer lines 6 Seepage pit 9 Feedyard 12 Fertilizer storage 16 Other (specify below)									
13 Insecticide storage									
Direction from well? <u>W</u> How many feet? <u>200</u>									
LITHOLOGIC LOG									
FROM TO LITHOLOGIC LOG FROM TO PLUGGING INTERVALS									
0 2 Soil									
2 11 Clay									
11 56 Red Shale									
CONTRACTOR'S OR LANDOWNER'S CERTIFICATION: This water well was (1) <u>constructed</u> , (2) reconstructed, or (3) plugged under my jurisdiction and was completed on (mo/day/year) <u>5-9-92</u> and this record is true to the best of my knowledge and belief. Kansas									
Water Well Contractor's License No. <u>395</u> This Water Well Record was completed on (mo/day/yr) <u>6-1-92</u>									
under the business name of <u>Craig Roberts Co.</u> by (signature) <u>Craig Roberts</u>									