

WATER WELL PLUGGING RECORD Form WWC-5P KSA 82a-1212 ID NO.

MW9


1 LOCATION OF WATER WELL: County: KINGMAN Fraction SE 1/4 SW 1/4 SE 1/4 1/4 Section Number 3 Township Number T 30 S Range Number 5 E W

Street/Rural Address of Well Location; if unknown, distance & direction from nearest town or intersection: If at owner's address, check here

Global Positioning Systems (GPS) information:
 Latitude: 37.46098 (in decimal degrees)
 Longitude: 97.8497963 (in decimal degrees)
 Elevation: _____
 Horizontal Datum: WGS84, NAD83, NAD27
 Collection Method: _____

2 WATER WELL OWNER: KYLE'S SERVICE
 RR#, St. Address, Box #: 110 W. BURNS
 City, State ZIP Code: NORWICH, KS 67118

GPS unit (Make/Model: _____)
 Digital Map/Photo, Topographic Map, Land Survey
 Est. Accuracy: < 3 m, 3-5 m, 5-15 m, > 15 m

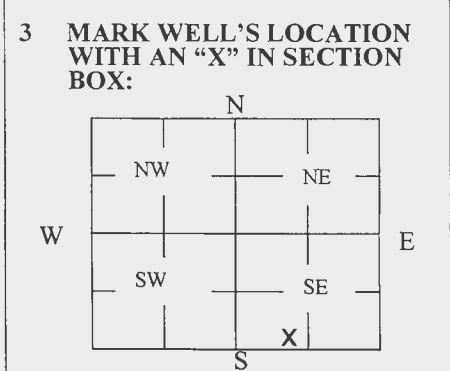

4 DEPTH OF WELL 24.29 ft.
 WELL'S STATIC WATER LEVEL 20.35 ft.
 WELL WAS USED AS:
 Domestic Public Water Supply Dewatering
 Irrigation Oil Field Water Supply Monitoring
 Feedlot Domestic (Lawn & Garden) Injection Well
 Industrial Air Conditioning Other _____
 Was a chemical/bacteriological sample submitted to Department? Yes No

5 TYPE OF BLANK CASING USED:

Steel RMP (SR) Wrought Fiberglass Other (Specify below)
 PVC ABS Asbestos-Cement Concrete Tile

Blank casing diameter 2 in. Was casing pulled? Yes No If yes, how much 1'
 Casing height above or below land surface 0 in.

6 GROUT PLUG MATERIAL: Neat cement Cement grout Bentonite Other SOIL 0-0.5

Grout Plug Intervals: From 0.5 ft. to 24.29 ft., From _____ ft. to _____ ft., From _____ ft. to _____ ft.


What is the nearest source of possible contamination:

Septic tank Seepage pit Fuel storage Other (specify below)
 Sewer lines Pit privy Fertilizer storage
 Watertight sewer lines Sewage lagoon Insecticide storage
 Lateral lines Feedyard Abandoned water well Direction from well? SOUTH
 Cess pool Livestock pens Oil well/Gas well How many feet? 90

| FROM | TO | PLUGGING MATERIALS | FROM | TO | PLUGGING MATERIALS |
|------|-------|--------------------|------|----|--------------------|
| 0 | 0.5 | SOIL | | | |
| 0.5 | 24.29 | BENTONITE | | | |
| | | | | | |
| | | | | | |
| | | | | | |

7 CONTRACTOR'S OR LANDOWNER'S CERTIFICATION: This water well was plugged under my jurisdiction and was completed on (mo/day/year) 8/4/22 and this record is true to the best of my knowledge and belief. Kansas Water Well Contractor's License No. 585. This Water Well Record was completed on (mo/day/year) 8/5/22 under the business name of ASSOCIATED ENVIRONMENTAL INC. by (signature) *[Signature]*

Send one white copy to Kansas Department of Health & Environment, Geology Section, 1000 SW Jackson Street, Ste. 420, Topeka, KS 66612-1367. Send one copy to WATER WELL OWNER and retain one for your records.
 Visit us at <http://www.kdheks.gov/waterwell/index.html> Telephone 785-296-5524.

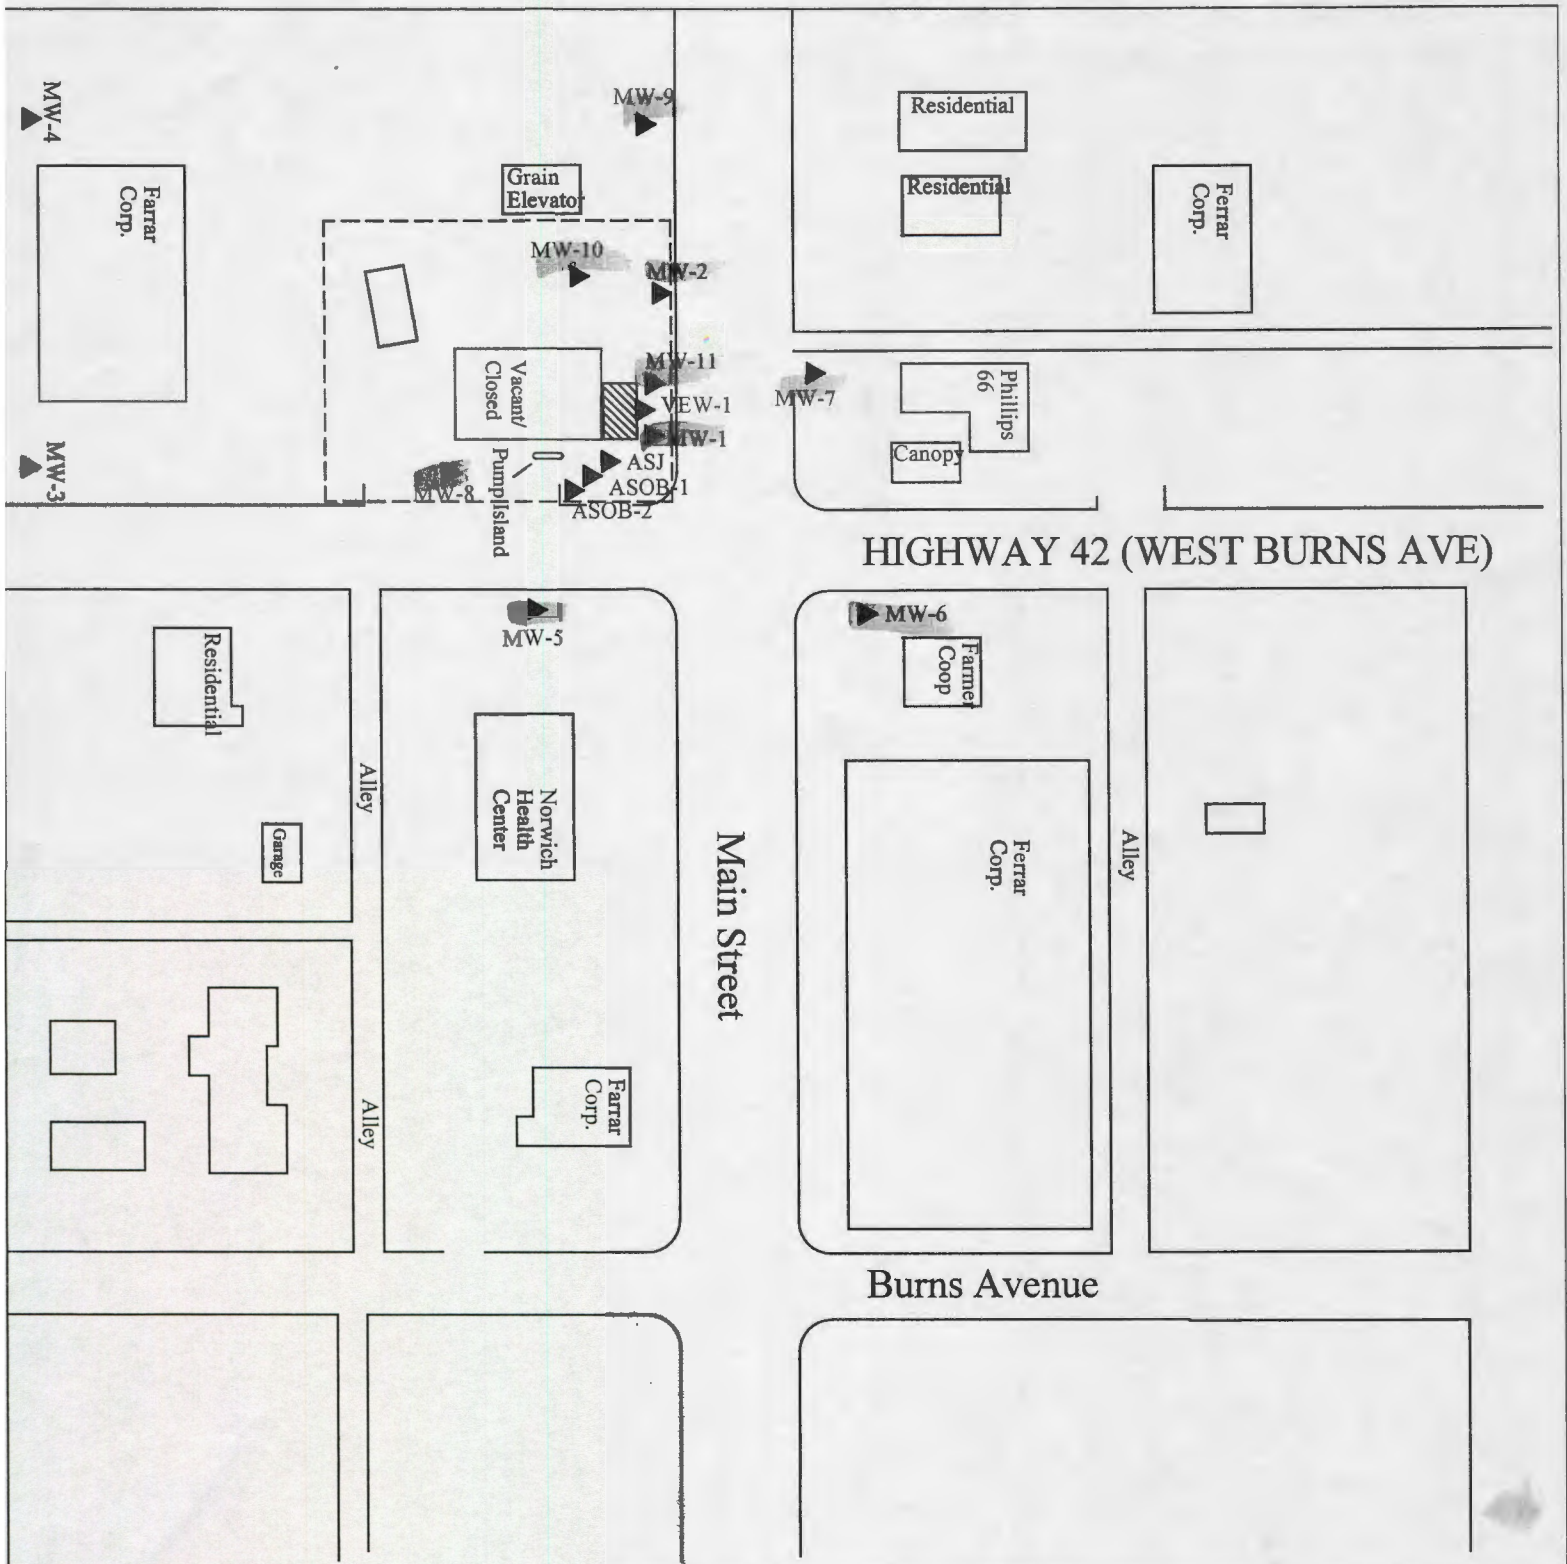

PROJECT: Kyle's Service
 ADDRESS: 110 W. Burns, W.Hwy 42
 LOCATION: Norwich, Kansas
 DRAWN BY: MM DATE: 01/06/96
 REVISED BY: B.STALNAKER DATE: 8/5/22
 AEI JOB #: TF296 KDHE JOB #: U2-048-00954
 SCALE: 1"=100'-0"
 0 50 100

TITLE:
 ASSOCIATED ENVIRONMENTAL INC.
 NOTES: Date Sampled: 9/1/20
 Former line locations are not known

LEGEND:
 ⊕ = Monitoring Well
 ▲ = Plugged Monitoring Well
 ▨ = Former Underground Fuel Storage Tank
 --- = Site Property Boundary

