

1 LOCATION OF WATER WELL:	Fraction	Section Number	Township Number	Range Number
County: <u>Kingman</u>	<u>SE 1/4 SE 1/4 NE 1/4</u>	<u>7</u>	T <u>30</u> S <u>6</u>	R <u>6</u> EW

Distance and direction from nearest town or city street address of well if located within city?

4E & S Rago2 WATER WELL OWNER: Bill Messenger

RR#, St. Address, Box #

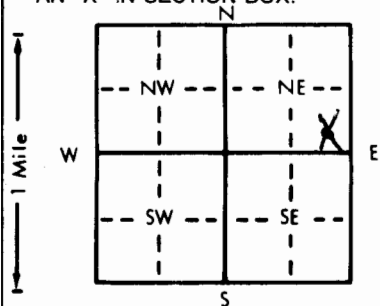
City, State, ZIP Code

Rago, Kans

Board of Agriculture, Division of Water Resources

Application Number:

3 LOCATE WELL'S LOCATION WITH AN "X" IN SECTION BOX:


WELL WATER TO BE USED AS: 5 Public water supply 8 Air conditioning 11 Injection well

1 Domestic 3 Feedlot 6 Oil field water supply 9 Dewatering 12 Other (Specify below)

2 Irrigation 4 Industrial 7 Lawn and garden only 10 Observation well

Was a chemical/bacteriological sample submitted to Department? Yes No; If yes, mo/day/yr sample was submittedWater Well Disinfected? Yes No

5 TYPE OF BLANK CASING USED:

5 Wrought iron

8 Concrete tile

CASING JOINTS: Glued Clamped

1 Steel 3 RMP (SR)

6 Asbestos-Cement

9 Other (specify below)

Welded

2 PVG 4 ABS

Fiberglass


TYPE OF SCREEN OR PERFORATION MATERIAL:

1 Steel 3 Stainless steel

5 Fiberglass

7 PVC

10 Asbestos-cement

2 Brass 4 Galvanized steel

6 Concrete tile

8 RMP (SR)

11 Other (specify)

SCREEN OR PERFORATION OPENINGS ARE: 5 Gauzed wrapped 8 Saw cut 11 None (open hole)

1 Continuous slot

3 Mill slot

6 Wire wrapped

9 Drilled holes

2 Louvered shutter

4 Key punched

7 Torch cut

10 Other (specify)

to 36 ft., From 13 ft. to 36 ft.7 CONTRACTOR'S OR LANDOWNER'S CERTIFICATION: This water well was (1) constructed, (2) reconstructed, or (3) plugged under my jurisdiction and was completed on (mo/day/year) 5-1-82 and this record is true to the best of my knowledge and belief. KansasWater Well Contractor's License No. 140 This Water Well Record was completed on (mo/day/yr) 5-1-82under the business name of Lyman Bros by (signature) Richard Lyman

INSTRUCTIONS: Use typewriter or ball point pen, PLEASE PRESS FIRMLY and PRINT clearly. Please fill in blanks, underline or circle the correct answers. Send top three copies to Kansas Department of Health and Environment, Division of Environment, Environmental Geology Section, Topeka, KS 66620. Send one to WATER WELL OWNER and retain one for your records.

OFFICE USE ONLY

T

30

R

6

EW

SEC.

7

SE 1/4

SE 1/4

NE 1/4