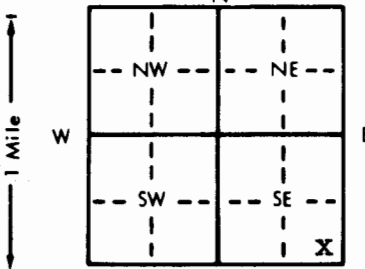


1 LOCATION OF WATER WELL: County: <u>Kingman</u>	Fraction <u>SE 1/4</u> <u>SE 1/4</u> <u>SE 1/4</u>	Section Number <u>1</u>	Township Number <u>T 30</u> <u>S</u>	Range Number <u>R 7</u> <u>E (W)</u>
---	---	----------------------------	---	---

Distance and direction from nearest town or city street address of well if located within city?

3 east Rago

2 WATER WELL OWNER: <u>Don Bramwell</u> RR#, St. Address, Box # : <u>Rt 1</u> City, State, ZIP Code : <u>Spivey, Kan 67142</u>	Board of Agriculture, Division of Water Resources Application Number:
--	--

3 LOCATE WELL'S LOCATION WITH AN "X" IN SECTION BOX: 	4 DEPTH OF COMPLETED WELL: <u>30</u> ft. ELEVATION: ft. Depth(s) Groundwater Encountered 1. <u>15</u> ft. 2. ft. 3. ft. WELL'S STATIC WATER LEVEL <u>6</u> ft. below land surface measured on mo/day/yr <u>1-16-89</u> Pump test data: Well water was ft. after hours pumping gpm Est. Yield <u>20</u> gpm: Well water was ft. after hours pumping gpm Bore Hole Diameter <u>9</u> in. to <u>30</u> ft., and in. to ft. WELL WATER TO BE USED AS: 5 Public water supply 8 Air conditioning 11 Injection well 1 Domestic 3 Feedlot 6 Oil field water supply 9 Dewatering 12 Other (Specify below) 2 Irrigation 4 Industrial 7 Lawn and garden only 10 Monitoring well Was a chemical/bacteriological sample submitted to Department? Yes..... No.....; If yes, mo/day/yr sample was submitted Water Well Disinfected? <u>Yes</u> No
--	--

5 TYPE OF BLANK CASING USED: 1 Steel 3 RMP (SR) 5 Wrought iron 8 Concrete tile CASING JOINTS: <u>Glued</u> Clamped 2 PVC 4 ABS 6 Asbestos-Cement 9 Other (specify below) Welded 7 Fiberglass Threaded	Blank casing diameter <u>2.5</u> in. to <u>17</u> ft., Dia. <u>5.22ft</u> in. to <u>30</u> ft., Dia. in. to ft. Casing height above land surface <u>16</u> in., weight lbs./ft. Wall thickness or gauge No. <u>214</u> TYPE OF SCREEN OR PERFORATION MATERIAL: 1 Steel 3 Stainless steel 5 Fiberglass 7 PVC 10 Asbestos-cement 2 Brass 4 Galvanized steel 6 Concrete tile 8 RMP (SR) 11 Other (specify) 9 ABS 12 None used (open hole) SCREEN OR PERFORATION OPENINGS ARE: 1 Continuous slot 3 Mill slot 5 Gauzed wrapped 8 Saw cut 11 None (open hole) 2 Louvered shutter 4 Key punched 6 Wire wrapped 9 Drilled holes 7 Torch cut 10 Other (specify) SCREEN-PERFORATED INTERVALS: From <u>17</u> ft. to <u>22</u> ft., From ft. to ft. From ft. to ft., From ft. to ft. GRAVEL PACK INTERVALS: From <u>13</u> ft. to <u>30</u> ft., From ft. to ft. From ft. to ft., From ft. to ft.
--	--

6 GROUT MATERIAL: 1 Neat cement 2 Cement grout 3 Bentonite 4 Other Grout Intervals: From <u>3</u> ft. to <u>13</u> ft., From ft. to ft., From ft. to ft. What is the nearest source of possible contamination: 1 Septic tank 4 Lateral lines 7 Pit privy 10 Livestock pens 14 Abandoned water well 2 Sewer lines 5 Cess pool 8 Sewage lagoon 11 Fuel storage 15 Oil well/Gas well 3 Watertight sewer lines 6 Seepage pit 9 Feedyard 12 Fertilizer storage 16 Other (specify below) 13 Insecticide storage Direction from well? <u>NW</u> How many feet? <u>350</u>

FROM	TO	LITHOLOGIC LOG	FROM	TO	PLUGGING INTERVALS
0	2	sandy soil			
2	8	fine sand			
8	15	medium sand			
15	30	shale			
Could Not Grout to 20 ft on account of formation					

7 CONTRACTOR'S OR LANDOWNER'S CERTIFICATION: This water well was (1) constructed, (2) reconstructed, or (3) plugged under my jurisdiction and was completed on (mo/day/year) <u>1-16-89</u> and this record is true to the best of my knowledge and belief. Kansas Water Well Contractor's License No. <u>140</u> This Water Well Record was completed on (mo/day/year) <u>1-31-89</u> under the business name of <u>Lyman Inc.</u> by (signature) <u>Dean Lyman</u>
--