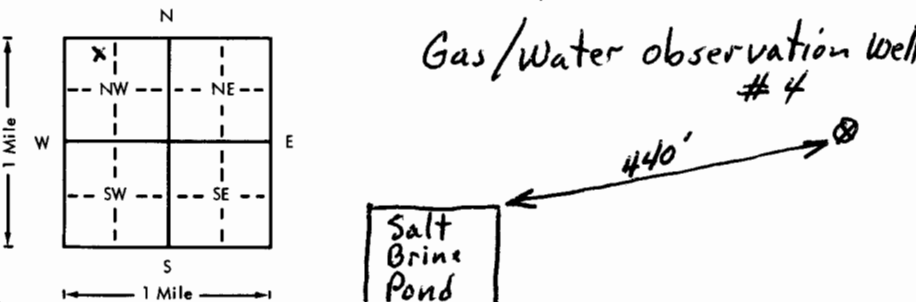


USE TYPEWRITER OR BALL
POINT PEN-PRESS FIRMLY,
PRINT CLEARLY.

WATER WELL RECORD
KSA 82a-1201-1215

Kansas Department of Health and
Environment-Division of Environment
(Water well Contractors)
Topeka, Kansas 66620

1. Location of well:		County Kingman	Fraction NE 1/4 NW 1/4 NW 1/4	Section number 15	Township number T 30 S R 7 E	Range number 7
2. Distance and direction from nearest town or city: Street address of well location if in city: 1 So. of Rago, Ks.				3. Owner of well: Phillips Petro. Co. (Pipe Line Div.) R.R. or street: Propane Storage Term. City, state, zip code: Rago, Ks. 67128		
4. Locate with "X" in section below: 				6. Bore hole dia. 9 1/4 in. Completion date 17 Dec 1976 Well depth 91 ft.		
5. Type and color of material				7. <input checked="" type="checkbox"/> Cable tool <input checked="" type="checkbox"/> Rotary <input type="checkbox"/> Driven <input type="checkbox"/> Dug <input type="checkbox"/> Hollow rod <input type="checkbox"/> Jetted <input type="checkbox"/> Bored <input type="checkbox"/> Reverse rotary		
				8. Use: <input type="checkbox"/> Domestic <input type="checkbox"/> Public supply <input checked="" type="checkbox"/> Industry <input type="checkbox"/> Irrigation <input type="checkbox"/> Air conditioning <input type="checkbox"/> Stock <input type="checkbox"/> Lawn <input type="checkbox"/> Oil field water <input type="checkbox"/> Other		
				9. Casing: Material Plastic Height Above or below Threaded <input type="checkbox"/> Welded <input type="checkbox"/> Surface 96 in. RMP <input checked="" type="checkbox"/> PVC <input type="checkbox"/> Weight 20 lbs./ft. Dia. 3 in. to 20 ft. depth Wall Thickness: inches or Dia. 3 in. to 36 ft. depth gage No. 160		
				10. Screen: Manufacturer's name Jess & Lowell Type RMP Dia. 3 Slot/gauze 1/8" Length 65 Set between 20 ft. and 30 ft. 36 ft. and 91 ft. Gravel pack? <input checked="" type="checkbox"/> Size range of material 1/8-3/8		
				11. Static water level: 10 ft. below land surface Date 12/17/76		
				12. Pumping level below land surfaces: ____ ft. after N/A hrs. pumping ____ g.p.m. ____ ft. after N/A hrs. pumping ____ g.p.m. Estimated maximum yield ____ g.p.m.		
				13. Water sample submitted: ____ mo./day/yr. Yes <input checked="" type="checkbox"/> No <input type="checkbox"/> Date ____		
				14. Well head completion: N/A Inches above grade ____ Pitless adapter		
				15. Well grouted? <input checked="" type="checkbox"/> 33-36 With: <input checked="" type="checkbox"/> Neat cement <input checked="" type="checkbox"/> Bentonite ____ Concrete Depth: From 0 ft. to 16 ft.		
				16. Nearest source of possible contamination: Brine Pond ft. 440 Direction SW Type Pond Well disinfected upon completion? <input checked="" type="checkbox"/> Yes ____ No		
				17. Pump: <input checked="" type="checkbox"/> Not installed Manufacturer's name ____ Model number ____ HP ____ Volts ____ Length of drop pipe ____ ft. capacity ____ g.p.m. Type: ____ Submersible ____ Turbine ____ Jet ____ Reciprocating ____ Centrifugal ____ Other		
				20. Water well contractor's certification: This well was drilled under my jurisdiction and this report is true to the best of my knowledge and belief. Wells Drilling Co. 112 Business name License No. ____ Address 1030 E Hwy 54 Signed Dean R. Wallace Date 1/1/77 Authorized representative		
18. Elevation:		19. Remarks: Gas/Water well - not for human consumption - observation only				
Topography: ____ Hill ____ Slope ____ Upland <input checked="" type="checkbox"/> Valley						