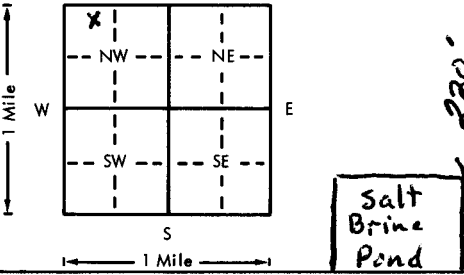


USE TYPEWRITER OR BALL
POINT PEN-PRESS FIRMLY,
PRINT CLEARLY.

WATER WELL RECORD
KSA 82a-1201-1215

Kansas Department of Health and
Environment-Division of Environment
(Water well Contractors)
Topeka, Kansas 66620

1. Location of well:		County Kingman	Fraction NE 1/4 NW 1/4 NW 1/4	Section number 15	Township number T 30 S R 7 E (W)	Range number 7
2. Distance and direction from nearest town or city: Street address of well location if in city: 1 So. of Rago, Ks.				3. Owner of well: Phillips Petro. Co. (Phillips Pipe Line) R.R. or street: Propane Storage Term. City, state, zip code: Rago, Ks. 67128		
4. Locate with "X" in section below:		Sketch map:		6. Bore hole dia. 9 1/4 in. Completion date 17 Dec 1976 Well depth 87 ft.		
		water well observation # 3		7. <input checked="" type="checkbox"/> Cable tool <input checked="" type="checkbox"/> Rotary <input type="checkbox"/> Driven <input type="checkbox"/> Dug <input type="checkbox"/> Hollow rod <input type="checkbox"/> Jetted <input type="checkbox"/> Bored <input type="checkbox"/> Reverse rotary		
5. Type and color of material				From	To	8. Use: <input type="checkbox"/> Domestic <input type="checkbox"/> Public supply <input checked="" type="checkbox"/> Industry <input type="checkbox"/> Irrigation <input type="checkbox"/> Air conditioning <input type="checkbox"/> Stock <input type="checkbox"/> Lawn <input type="checkbox"/> Oil field water <input type="checkbox"/> Other
Topsoil Sandy				0	8	9. Casing: Material Plastic Height: Above or below Threaded <input type="checkbox"/> Welded <input type="checkbox"/> Surface 96 in. RMP <input checked="" type="checkbox"/> PVC <input type="checkbox"/> Weight <input type="checkbox"/> lbs./ft.
Clay & Sand				8	10	Dia. 3 in. to 19 ft. depth Wall Thickness: inches or Dia. <input type="checkbox"/> in. to <input type="checkbox"/> ft. depth gage No. 160
White Clay				10	13	10. Screen: Manufacturer's name Jess & Lowell Type RMP Dia. 3 Slot/gauze 1/8" Length 18 Set between 19 ft. and 38 ft. Gravel pack? <input checked="" type="checkbox"/> Size range of material 1/4-3/4
Med-C Sand				13	22	11. Static water level: <input type="checkbox"/> mo./day/yr. 9 ft. below land surface Date 12/17/76
Clay				22	30	12. Pumping level below land surfaces: ____ ft. after N/A hrs. pumping ____ g.p.m. ____ ft. after N/A hrs. pumping ____ g.p.m. Estimated maximum yield ____ g.p.m.
Med Sand				30	38	13. Water sample submitted: ____ mo./day/yr. Yes <input checked="" type="checkbox"/> No <input type="checkbox"/> Date ____
Red Bed				38	-	14. Well head completion: N/A ____ Pitless adapter ____ Inches above grade
						15. Well grouted? <input checked="" type="checkbox"/> With: <input checked="" type="checkbox"/> Neat cement <input type="checkbox"/> Bentonite <input type="checkbox"/> Concrete Depth: From 0 ft. to 16 ft.
						16. Nearest source of possible contamination: Brine Pond ft. 220 Direction S Type Pond Well disinfected upon completion? <input checked="" type="checkbox"/> Yes <input type="checkbox"/> No
						17. Pump: <input checked="" type="checkbox"/> Not installed Manufacturer's name ____ Model number ____ HP ____ Volts ____ Length of drop pipe ____ ft. capacity ____ g.p.m. Type: ____ Submersible ____ Turbine ____ Jet ____ Reciprocating ____ Centrifugal ____ Other
18. Elevation:		19. Remarks:		20. Water well contractor's certification: This well was drilled under my jurisdiction and this report is true to the best of my knowledge and belief. Wells Drilling Co. 112 Business name License No. ____ Address 1030 E Hwy 54 Signed Dean K. Wallace Date 1/11/77 Authorized representative		