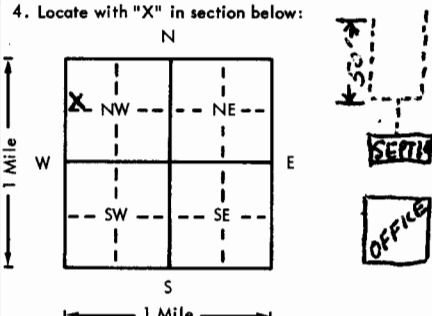


USE TYPEWRITER OR BALL
POINT PEN-PRESS FIRMLY,
PRINT CLEARLY.

WATER WELL RECORD
KSA 82a-1201-1215

Kansas Department of Health and
Environment-Division of Environment
(Water well Contractors)
Topeka, Kansas 66620

1. Location of well:		County Kingman	Fraction SW 1/4 NW 1/4 NW 1/4	Section number 15	Township number T 30 S R 7 E (W)	Range number 7
2. Distance and direction from nearest town or city: Street address of well location if in city: 1 So. of Rago, Ks.			3. Owner of well: Phillips Petro. Co. (Phillips Pipe Line) R.R. or street: Propane Storage Term. City, state, zip code: Rago, Ks. 67128			
4. Locate with "X" in section below: 		6. Bore hole dia. 28 in. Completion date 12 Dec 1976 Well depth 55 ft.				
5. Type and color of material		From	To	7. <input type="checkbox"/> Cable tool <input type="checkbox"/> Rotary <input type="checkbox"/> Driven <input type="checkbox"/> Dug <input type="checkbox"/> Hollow rod <input type="checkbox"/> Jetted <input type="checkbox"/> Bored <input checked="" type="checkbox"/> Reverse rotary		
Topsoil (Sandy)		0	6	8. Use: <input type="checkbox"/> Domestic <input type="checkbox"/> Public supply <input checked="" type="checkbox"/> Industry <input type="checkbox"/> Irrigation <input type="checkbox"/> Air conditioning <input type="checkbox"/> Stock <input type="checkbox"/> Lawn <input type="checkbox"/> Oil field water <input type="checkbox"/> Other		
F-Sand		6	10	9. Casing: Material Steel Height: Above or below Threaded <input type="checkbox"/> Welded <input checked="" type="checkbox"/> Surface 18 in. RMP <input type="checkbox"/> PVC <input type="checkbox"/> Weight <input type="checkbox"/> lbs./ft. Dia. 16 in. to 55 ft. depth Wall Thickness: inches or Dia. <input type="checkbox"/> in. to <input type="checkbox"/> ft. depth gage No. 10		
Clay		10	13	10. Screen: Manufacturer's name W.A. Brown Ent. Type St. Free Flow Dia. 16" Slot/gauze 1/4" Length 20' Set between 35 ft. and 55 ft. Gravel pack? <input checked="" type="checkbox"/> Size range of material 1/8-3/8		
Med-C. Sand		13	22	11. Static water level: 10 ft. below land surface Date 12/12/76		
C Sand		22	28	12. Pumping level below land surfaces: ____ ft. after ____ hrs. pumping ____ g.p.m. ____ ft. after N/A hrs. pumping ____ g.p.m. Estimated maximum yield ____ g.p.m.		
Clay		28	38	13. Water sample submitted: ____ mo./day/yr. Yes <input checked="" type="checkbox"/> No <input type="checkbox"/> Date ____		
C Sand w/ Red Rock		38	43	14. Well head completion: ____ Pitless adapter ____ Inches above grade		
C Sand & Gravel		43	55	15. Well grouted? <input checked="" type="checkbox"/> With: <input checked="" type="checkbox"/> Neat cement <input type="checkbox"/> Bentonite <input type="checkbox"/> Concrete Depth: From 0 ft. to 20 ft.		
Red Bed		55	-	16. Nearest source of possible contamination: ft. 200 Direction NW Type SEPTIC Well disinfected upon completion? <input checked="" type="checkbox"/> Yes <input type="checkbox"/> No		
				17. Pump: <input checked="" type="checkbox"/> Not installed Manufacturer's name ____ Model number ____ HP ____ Volts ____ Length of drop pipe ____ ft. capacity ____ g.p.m. Type: <input type="checkbox"/> Submersible <input type="checkbox"/> Turbine <input type="checkbox"/> Jet <input type="checkbox"/> Reciprocating <input type="checkbox"/> Centrifugal <input type="checkbox"/> Other		
18. Elevation:		19. Remarks:		20. Water well contractor's certification: This well was drilled under my jurisdiction and this report is true to the best of my knowledge and belief. Wells Drilling Co. 112 Business name License No. ____ Address 1030 E Hwy 54 Signed Dean K. Wallace Date 1/11/77 Authorized representative		
Topography: <input type="checkbox"/> Hill <input type="checkbox"/> Slope <input type="checkbox"/> Upland <input checked="" type="checkbox"/> Valley		Pump Installed by customer This well is not for human consumption - to be used for flooding underground propane storage				

30-70-15
1/4 1/4 1/4
SUNN