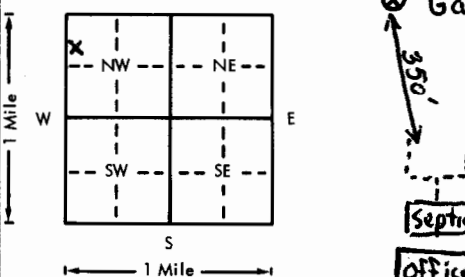


USE TYPEWRITER OR BALL
POINT PEN-PRESS FIRMLY,
PRINT CLEARLY.

WATER WELL RECORD
KSA 82a-1201-1215

Kansas Department of Health and
Environment-Division of Environment
(Water well Contractors)
Topeka, Kansas 66620

1. Location of well:		County Kingman	Fraction SW 1/4 NW 1/4 NW 1/4	Section number 15	Township number T 30 S R 7 E	Range number 7
2. Distance and direction from nearest town or city:		3. Owner of well: Phillips Petro. Co. (Phillips Pipe Line)				
Street address of well location if in city: 1 So. of Rago, Ks.		R.R. or street: Propane Storage Term. City, state, zip code: Rago, Ks. 67128				
4. Locate with "X" in section below:		Sketch map:		6. Bore hole dia. 9 1/4 in. Completion date 17 Dec 1976 Well depth 94 ft.		
				7. Cable tool <input checked="" type="checkbox"/> Rotary <input type="checkbox"/> Driven <input type="checkbox"/> Dug Hollow rod <input type="checkbox"/> Jetted <input type="checkbox"/> Bored <input type="checkbox"/> Reverse rotary		
5. Type and color of material		From	To	8. Use: Domestic <input type="checkbox"/> Public supply <input type="checkbox"/> Industry <input checked="" type="checkbox"/> Irrigation <input type="checkbox"/> Air conditioning <input type="checkbox"/> Stock Lawn <input type="checkbox"/> Oil field water <input type="checkbox"/> Other		
Topsoil Sandy		0	4	9. Casing: Material Plastic Height Above or below Threaded <input type="checkbox"/> Welded <input type="checkbox"/> Surface 16 in. RMP <input checked="" type="checkbox"/> PVC <input type="checkbox"/> Weight <input type="checkbox"/> lbs./ft. Dia. 3 in. to 22 ft. depth Wall Thickness: inches or Dia. 3 in. to 39 ft. depth gage No. 160		
Clay w/sand streaks		4	8	10. Screen: Manufacturer's name Jess & Lowell Type RMP Dia. 3 Slot/gauze 1/8" Length 65' Set between 22 ft. and 32 ft. 39 ft. and 94 ft. Gravel pack? <input checked="" type="checkbox"/> Size range of material 1/8-3/8		
Clay		8	12	11. Static water level: 12 ft. below land surface Date 12/17/76 mo./day/yr.		
C Sand		12	18	12. Pumping level below land surfaces: ft. after N/A hrs. pumping <input type="checkbox"/> g.p.m. ft. after N/A hrs. pumping <input type="checkbox"/> g.p.m. Estimated maximum yield <input type="checkbox"/> g.p.m.		
Clay		18	34	13. Water sample submitted: <input type="checkbox"/> Yes <input checked="" type="checkbox"/> No Date <input type="checkbox"/>		
Med-C Sand		34	44	14. Well head completion: N/A Pitless adapter <input type="checkbox"/> inches above grade		
Red Rock		44	94	15. Well grouted? <input checked="" type="checkbox"/> With: <input checked="" type="checkbox"/> Neat cement <input checked="" type="checkbox"/> Bentonite <input type="checkbox"/> Concrete Depth: From 0 ft. to 20 ft.		
				16. Nearest source of possible contamination: ft. 350 Direction S Type SEPTIC Well disinfected upon completion? <input checked="" type="checkbox"/> Yes <input type="checkbox"/> No		
				17. Pump: <input checked="" type="checkbox"/> Not installed Manufacturer's name <input type="checkbox"/> Model number <input type="checkbox"/> HP <input type="checkbox"/> Volts <input type="checkbox"/> Length of drop pipe <input type="checkbox"/> ft. capacity <input type="checkbox"/> g.p.m. Type: <input type="checkbox"/> Submersible <input type="checkbox"/> Turbine <input type="checkbox"/> Jet <input type="checkbox"/> Reciprocating <input type="checkbox"/> Centrifugal <input type="checkbox"/> Other		
18. Elevation:		19. Remarks:		20. Water well contractor's certification: This well was drilled under my jurisdiction and this report is true to the best of my knowledge and belief. Wells Drilling Co. 112 Business name 1030 E Hwy 54 License No. Address Neon K. Wallace Date 1/1/77 Signed Neon K. Wallace Authorized representative		
Topography: <input type="checkbox"/> Hill <input type="checkbox"/> Slope <input type="checkbox"/> Upland <input checked="" type="checkbox"/> Valley						