


1 LOCATION OF WATER WELL: Fraction NE 1/4 SE 1/4 SE 1/4 Section Number 26 Township Number 30 S Range Number 8 E/W

County: Kingman Distance and direction from nearest town or city street address of well if located within city?

2 WATER WELL OWNER: Len Messinger 14600 SW 70 Ave Board of Agriculture, Division of Water Resources
RR#, St. Address, Box # : Zenda, KS 67159 Application Number:

3 LOCATE WELL'S LOCATION WITH AN "X" IN SECTION BOX: 4 DEPTH OF COMPLETED WELL 92 ft. ELEVATION: 75

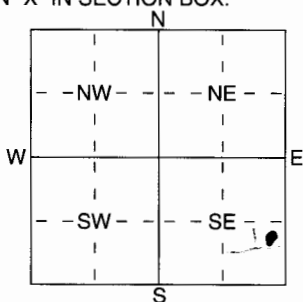

Depth(s) Groundwater Encountered 15 ft. 2 75 ft. 3 5-2-05 ft.
WELL'S STATIC WATER LEVEL 15 ft. below land surface measured on mo/day/yr
Pump test data: Well water was 10 ft. after 10 hours pumping 10 gpm
Est. Yield 10 gpm: Well water was 10 ft. after 10 hours pumping 10 gpm
WELL WATER TO BE USED AS: 5 Public water supply 8 Air conditioning 11 Injection well
1 Domestic 3 Feedlot 6 Oil field water supply 9 Dewatering 12 Other (Specify below)
2 Irrigation 4 Industrial 7 Domestic (lawn & garden) 10 Monitoring well

Was a chemical/bacteriological sample submitted to Department? Yes X No 9 If yes, mo/day/yr sample was submitted Water Well Disinfected? Yes 9 No

5 TYPE OF BLANK CASING USED: 1 Steel 3 RMP (SR) 5 Wrought iron 8 Concrete tile CASING JOINTS: Glued X Clamped
2 PVC 4 ABS 6 Asbestos-Cement 9 Other (specify below) Welded
TYPE OF SCREEN OR PERFORATION MATERIAL: 7 PVC 10 Asbestos-Cement
1 Steel 3 Stainless Steel 5 Fiberglass 8 RMP (SR) 11 Other (Specify)
2 Brass 4 Galvanized Steel 6 Concrete tile 9 ABS 12 None used (open hole)

SCREEN OR PERFORATION OPENINGS ARE: 5 Gauzed wrapped 8 Saw cut 11 None (open hole)
1 Continuous slot 3 Mill slot 6 Wire wrapped 9 Drilled holes
2 Louvered shutter 4 Key punched 7 Torch cut 10 Other (specify) 92 ft.


6 GROUT MATERIAL: 1 Neat cement 2 Cement grout 3 Bentonite 4 Other
Grout Intervals: From 0 ft. to 20 ft., From 20 ft. to 92 ft., From 92 ft. to 92 ft.

What is the nearest source of possible contamination: 10 Livestock pens 14 Abandoned water well
1 Septic tank 4 Lateral lines 7 Pit privy 11 Fuel storage 15 Oil well/Gas well
2 Sewer lines 5 Cess pool 8 Sewage lagoon 12 Fertilizer storage 16 Other (specify below)
3 Watertight sewer lines 6 Seepage pit 9 Feedyard 13 Insecticide storage
Direction from well? None within 1,000' How many feet?

FROM	TO	LITHOLOGIC LOG	FROM	TO	PLUGGING INTERVALS
0	3	Soil			
3	6	Gravel			
6	12	Whit Clay			
12	25	Fine sand.			
25	42	Sand.			
42	55	Sand and Clay Mix.			
55	58	Yellow Sand.			
58	73	Fine sand.			
73	91	Sand some Medium.			
91	92	Red shale			

7 CONTRACTOR'S OR LANDOWNER'S CERTIFICATION: This water well was (1) constructed, (2) reconstructed, or (3) plugged under my jurisdiction and was completed on (mo/day/year) 5-2-75 and this record is true to the best of my knowledge and belief. Kansas Water Well Contractor's Licence No. 140 This Water Well Record was completed on (mo/day/yr) 5-24-05 under the business name of Lyman's Inc by (signature) Lyman