

1 LOCATION OF WATER WELL:	Fraction	Section Number	Township Number	Range Number
County: KINGMAN	SE ¼ SW ¼ SE ¼	29	T 30 S	R 8 EW

Distance and direction from nearest town or city street address of well if located within city?

3Miles West, 2Miles South, of Spivey Kans. 67068

2 WATER WELL OWNER: Messenger PETROLEUM, Inc.


RR#, St. Address, Box #: 1015 East Hiway 54 East

Board of Agriculture, Division of Water Resources

City, State, ZIP Code: Kingman, Kans. 67068

Application Number:

3 LOCATE WELL'S LOCATION WITH AN "X" IN SECTION BOX:

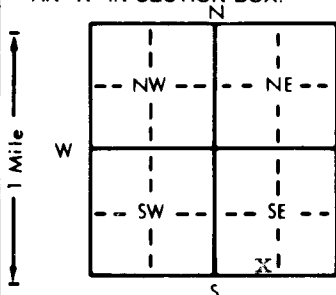

4 DEPTH OF COMPLETED WELL: 84' ft. ELEVATION:

Depth(s) Groundwater Encountered 1. 22' ft. 2. ft. 3. ft.

WELL'S STATIC WATER LEVEL: 22' ft. below land surface measured on mo/day/yr Jan. 26-1998.

Pump test data: Well water was NA ft. after hours pumping gpm

Est. Yield 50 gpm: Well water was ft. after hours pumping gpm

Bore Hole Diameter: 8 1/4" in. to 84' ft., and in. to ft.

WELL WATER TO BE USED AS: 5 Public water supply 8 Air conditioning 11 Injection well

1 Domestic 3 Feedlot XX6 Oil field water supply 9 Dewatering 12 Other (Specify below)

2 Irrigation 4 Industrial 7 Lawn and garden only 10 Monitoring well

Was a chemical/bacteriological sample submitted to Department? Yes No X If yes, mo/day/yr sample was submitted

Water Well Disinfected? Yes X No

5 TYPE OF BLANK CASING USED:

5 Wrought iron

8 Concrete tile

CASING JOINTS: Glued X Clamped

1 Steel

3 RMP (SR)

6 Asbestos-Cement

9 Other (specify below)

Welded

XX2 PVC

4 ABS

7 Fiberglass

Threaded

Blank casing diameter 5" in. to 40' ft., Dia in. to ft., Dia in. to ft.

Casing height above land surface 16" in., weight 2.34 lbs./ft. Wall thickness or gauge No. 2.48

TYPE OF SCREEN OR PERFORATION MATERIAL:

XX7 PVC

10 Asbestos-cement

1 Steel

3 Stainless steel

5 Fiberglass

8 RMP (SR)

11 Other (specify)

2 Brass

4 Galvanized steel

6 Concrete tile

9 ABS

12 None used (open hole)

SCREEN OR PERFORATION OPENINGS ARE:

5 Gauzed wrapped

XX Saw cut

11 None (open hole)

1 Continuous slot

3 Mill slot

6 Wire wrapped

9 Drilled holes

2 Louvered shutter

4 Key punched

7 Torch cut

10 Other (specify)

SCREEN-PERFORATED INTERVALS: From 84' ft. to 40' ft., From ft. to ft.

From ft. to ft., From ft. to ft.

GRAVEL PACK INTERVALS: From ft. to ft., From ft. to ft.

From 84' ft. to 27' ft., From ft. to ft.

6 GROUT MATERIAL:

1 Neat cement

2 Cement grout

XX3 Bentonite

4 Other

Grout Intervals: From 27' ft. to 3' ft., From ft. to ft., From ft. to ft.

What is the nearest source of possible contamination:

1 Septic tank

4 Lateral lines

7 Pit privy

10 Livestock pens

14 Abandoned water well

2 Sewer lines

5 Cess pool

8 Sewage lagoon

11 Fuel storage

XX5 Oil well/Gas well

3 Watertight sewer lines

6 Seepage pit

9 Feedyard

12 Fertilizer storage

16 Other (specify below)

13 Insecticide storage

Direction from well?

East

How many feet? APP: 1320'

FROM	TO	LITHOLOGIC LOG	FROM	TO	PLUGGING INTERVALS
0'	2'	Top Soil.			
2'	3'	Medium Course Sand.			
3'	5'	Grey Clay.			
5'	16'	Fine Sand.			
16'	21'	Medium Course Sand.			
21'	34'	Medium Fine SAND.			
34'	42'	Clay.			
42'	57'	Medium Fine Sand.			
57'	76'	ClayW/ Clay Strips.			
76'	84'	Brown Clay.			
84'		Red Bed.			

7 CONTRACTOR'S OR LANDOWNER'S CERTIFICATION: This water well was (1) constructed, (2) reconstructed, or (3) plugged under my jurisdiction and was completed on (mo/day/year) Jan. 26, 1998. and this record is true to the best of my knowledge and belief. Kansas

Water Well Contractor's License No. 112 This Water Well Record was completed on (mo/day/yr) Feb. 26, 1998.

under the business name of WELLS DRILLING CO.

by (signature) Dal Wells