

USE TYPEWRITER OR BALL POINT PEN-PRESS FIRMLY, PRINT CLEARLY.


T R EW sec 1/4 1/4 1/4 No.

WATER WELL RECORD
KSA 82a-1201-1215

Kansas State Dept. Of Health
(Water Well Contractors)
Forbes-Bldg. 740
Topeka, Kansas 66620

1 Location of well:	County KINGMAN	Township name	Fraction SESESE	Section number 9	Town number 30 S	Range number 9 W
---------------------	--------------------------	---------------	---------------------------	----------------------------	----------------------------	----------------------------

Distance and direction from nearest town or city: Street address of well location if in city: 1 W. Zenda	3 Owner of well: Address: Red Tiger Drilling Co. 1720 Wichita Plaza Wichita, KS
--	---

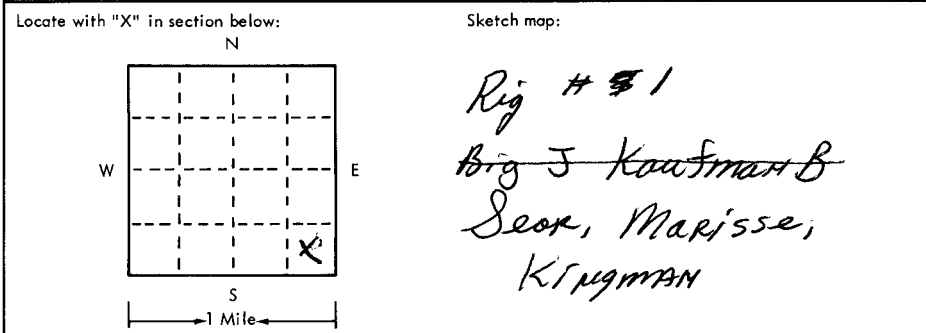

4 Well depth: 115 ft. Date of completion 3-15-75 Well diameter 7 in.
5 <input type="checkbox"/> Cable tool <input checked="" type="checkbox"/> Rotary <input type="checkbox"/> Driven <input type="checkbox"/> Dug <input type="checkbox"/> Hollow rod <input type="checkbox"/> Jetted <input type="checkbox"/> Bored <input type="checkbox"/> Reverse rotary
6 Use: <input type="checkbox"/> Domestic <input type="checkbox"/> Public supply <input type="checkbox"/> Industry <input type="checkbox"/> Irrigation <input type="checkbox"/> Air conditioning <input type="checkbox"/> Commercial <input type="checkbox"/> Test well <input checked="" type="checkbox"/> Oil Rig
7 Casing: Material PVC Height: <input checked="" type="checkbox"/> above <input type="checkbox"/> below Threaded <input type="checkbox"/> Welded <input type="checkbox"/> Surface 12 in. Diam. _____ Weight _____ lbs./ft. _____ 4 in. to 115 ft. depth! Drive shoe? <input type="checkbox"/> Yes <input checked="" type="checkbox"/> No _____ in. to _____ ft. depth!

2	Type and color of material	From	To
	Top Soil + clay	0	40
	Sand-clay	40	115
<p>This was plugged by Red Tiger Drilling at 1720 Wichita Plaza, Wichita, KS 67202 by written com. to Robert A Yancey, according to 28-30-7 Abandonment Regulations (1), (2) + 3. Received their reply on 4/23/75 DLB</p>			
(use a second sheet if needed)			

8 Screen: Manufacturer M.P.I. Type PVC Dia. 4 Slot/gauze 1/16" Length 20 Set between 95 ft. and 115 ft. Fittings: _____ Gravel pack <input checked="" type="checkbox"/> Yes <input type="checkbox"/> No Size range of material 1/2 - 3/4"
9 Static water level: 45 ft. below land surface Date 3-15-75
10 Pumping level below land surfaces: _____ ft. after _____ hrs. pumping _____ g.p.m. _____ ft. after _____ hrs. pumping _____ g.p.m. Estimated maximum yield 40 g.p.m.

11 Water sample submitted: <input type="checkbox"/> Yes <input checked="" type="checkbox"/> No Date _____
12 Well head completion: <input type="checkbox"/> Pitless adapter <input checked="" type="checkbox"/> Inches above grade 12"
13 Well grouted? <input checked="" type="checkbox"/> Yes <input type="checkbox"/> No <input type="checkbox"/> Neat cement <input checked="" type="checkbox"/> Bentonite <input type="checkbox"/> _____ Depth: From 0 ft. to 10 ft.
14 Nearest source of possible contamination: ft. 75 Direction SW Type Oil Test Well disinfected upon completion? <input type="checkbox"/> Yes <input checked="" type="checkbox"/> No
15 Pump: <input checked="" type="checkbox"/> Not installed Manufacturer's name _____ Model number _____ HP _____ Volts _____ Length of drop pipe _____ ft. capacity _____ g.m.p. Type: <input type="checkbox"/> Submersible <input type="checkbox"/> Turbine <input type="checkbox"/> Jet <input type="checkbox"/> Reciprocating <input type="checkbox"/> Centrifugal <input type="checkbox"/> Other

16 Remarks: elevation

Topography:
 Hill
 Slope
 Upland
 Valley

17 Water well contractor's certification:
This well was drilled under my jurisdiction and this report is true to the best of my knowledge and belief.
Nellys Water-Well Ser 186
Business name _____ License No. _____
Address **P.O. Great Bend KS**
Signed **Nellys** Date **3-20-75**
Authorized representative