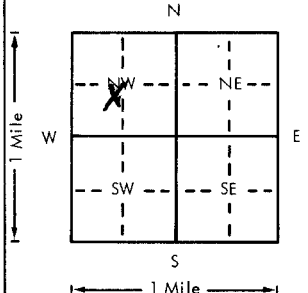


USE TYPEWRITER OR BALL  
POINT PEN-PRESS FIRMLY,  
PRINT CLEARLY.

WATER WELL RECORD  
KSA 82a-1201-1215

Kansas Department of Health and  
Environment-Division of Environment  
(Water well Contractors)  
Topeka, Kansas 66620

1. Location of well:		County <b>KINGMAN</b>	Fraction <b>NE 1/4 SW 1/4 NW 1/4</b>	Section number <b>15</b>	Township number <b>T 30 S</b>	Range number <b>R 9 W E/W</b>
2. Distance and direction from nearest town or city: <b>1 W of Zenda, Ks</b>			3. Owner of well: <b>Sweetman Drilling Co.</b> R.R. or street: City, state, zip code: <b>Wichita, Ks</b>			
4. Locate with "X" in section below: 			6. Bore hole dia. <b>10</b> in. Completion date <b>4 Apr 78</b> Well depth <b>90</b> ft.			
			7. <input checked="" type="checkbox"/> Cable tool <input checked="" type="checkbox"/> Rotary <input type="checkbox"/> Driven <input type="checkbox"/> Dug <input type="checkbox"/> Hollow rod <input type="checkbox"/> Jetted <input type="checkbox"/> Bored <input type="checkbox"/> Reverse rotary			
			8. Use: <input type="checkbox"/> Domestic <input type="checkbox"/> Public supply <input type="checkbox"/> Industry <input type="checkbox"/> Irrigation <input type="checkbox"/> Air conditioning <input type="checkbox"/> Stock <input type="checkbox"/> Lawn <input checked="" type="checkbox"/> Oil field water <input type="checkbox"/> Other			
			9. Casing: Material <input type="checkbox"/> Height: <b>above</b> or below Threaded <input type="checkbox"/> Welded <input type="checkbox"/> Surface <b>12</b> in. RMP <input type="checkbox"/> PVC <input checked="" type="checkbox"/> Weight <input type="checkbox"/> lbs./ft. Dia. <b>5</b> in. to <b>30</b> ft. depth Wall Thickness: inches or Dia. <input type="checkbox"/> in. to <input type="checkbox"/> ft. depth gage No. <b>1258</b>			
5. Type and color of material			From	To	10. Screen: Manufacturer's name <b>Plentis</b> Type <b>saw slot</b> Dia. <b>5</b> Slot/gauze <b>18</b> Length <b>30'</b> Set between <b>30</b> ft. and <b>50</b> ft. <b>80</b> ft. and <b>90</b> ft. Gravel pack? <input checked="" type="checkbox"/> Size range of material <b>1/4 X 1/4</b>	
Soil			0	2	11. Static water level: <b>28</b> ft. below land surface Date <b>4 Apr 78</b> mo./day/yr.	
Clay, tan			2	6	12. Pumping level below land surfaces: ft. after hrs. pumping g.p.m. ft. after hrs. pumping g.p.m. Estimated maximum yield <b>50</b> g.p.m.	
Sand, fine			6	22	13. Water sample submitted: <input checked="" type="checkbox"/> Yes <input type="checkbox"/> No Date	
Sand, fine to coarse and fine gravel			22	50	14. Well head completion: <b>12</b> inches above grade Pitless adapter	
Clay, blue and brown			50	70	15. Well grouted? <input checked="" type="checkbox"/> X With: <input checked="" type="checkbox"/> Neat cement <input type="checkbox"/> Bentonite <input type="checkbox"/> Concrete Depth: From <b>0</b> ft. to <b>10</b> ft.	
Caliche, and white sandy clay			70	76	16. Nearest source of possible contamination: ft. Direction Type <b>above</b> Well disinfected upon completion? <input checked="" type="checkbox"/> Yes <input type="checkbox"/> No	
Clay, tan			76	80	17. Pump: <input checked="" type="checkbox"/> Not installed Manufacturer's name Model number HP Volts Length of drop pipe ft. capacity g.p.m. Type: <input type="checkbox"/> Submersible <input type="checkbox"/> Turbine <input type="checkbox"/> Jet <input type="checkbox"/> Reciprocating <input type="checkbox"/> Centrifugal <input type="checkbox"/> Other	
Sand, fine to coarse and fine gravel, silty			80	85		
Sand, silty with clay streaks			85	90		
Shale, red			90	96		
(Use a second sheet if needed)						
Topography: <input type="checkbox"/> Hill <input type="checkbox"/> Slope <input checked="" type="checkbox"/> Upland <input type="checkbox"/> Valley						