


1 LOCATION OF WATER WELL: County: <u>Sumner</u>	Fraction <u>NE</u> $\frac{1}{4}$ <u>SE</u> $\frac{1}{4}$ <u>SE</u> $\frac{1}{4}$	Section Number <u>26</u>	Township Number T <u>31</u> S	Range Number R <u>1</u> E <u>W</u>
--	---	-----------------------------	----------------------------------	---------------------------------------

Distance and direction from nearest town or city street address of well if located within city?

Rt 81 North of Wellington \approx 3 milesMW-1

2 WATER WELL OWNER: RR#, St. Address, Box # : City, State, ZIP Code	<u>Lamar Electro-Air</u> <u>P.O. Box 10 Wellington Airport</u> <u>Wellington, KS 67152</u>	Board of Agriculture, Division of Water Resources Application Number:
---	--	--

3 LOCATE WELL'S LOCATION WITH AN "X" IN SECTION BOX:	4 DEPTH OF COMPLETED WELL <u>32</u> ft. ELEVATION:
--	--

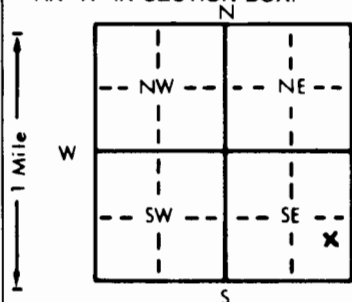

Depth(s) Groundwater Encountered	1	ft. 2.	ft. 3.	ft.
WELL'S STATIC WATER LEVEL	ft. below land surface measured on mo/day/yr			
Pump test data: Well water was	ft. after	hours pumping	gpm	
Est. Yield	gpm	Well water was	ft. after	hours pumping
Bore Hole Diameter	<u>7 7/8</u> in. to	<u>32</u> ft. and	in. to	ft.
WELL WATER TO BE USED AS:	5 Public water supply	8 Air conditioning	11 Injection well	
1 Domestic	3 Feedlot	6 Oil field water supply	9 Dewatering	12 Other (Specify below)
2 Irrigation	4 Industrial	7 Lawn and garden only	10 Monitoring well	
Was a chemical/bacteriological sample submitted to Department? Yes <input type="checkbox"/> No <input checked="" type="checkbox"/> If yes, mo/day/yr sample was submitted				
Water Well Disinfected? Yes <input type="checkbox"/> No <input checked="" type="checkbox"/>				

5 TYPE OF BLANK CASING USED:	5 Wrought iron	8 Concrete tile	CASING JOINTS: Glued	Clamped
1 Steel	3 RMP (SR)	6 Asbestos-Cement	9 Other (specify below)	Welded
2 PVC	4 ABS	7 Fiberglass		Threaded <input checked="" type="checkbox"/>
Blank casing diameter	<u>4</u> in. to	<u>22</u> ft. Dia	in. to	ft. Dia
Casing height above land surface	<u>0</u> in. weight	<u>Sch 40</u> lbs./ft. Wall thickness or gauge No.		
TYPE OF SCREEN OR PERFORATION MATERIAL:	1 Steel	3 Stainless steel	5 Fiberglass	8 RMP (SR)
2 Brass	4 Galvanized steel	6 Concrete tile	9 ABS	11 Other (specify)
SCREEN OR PERFORATION OPENINGS ARE:	5 Gauzed wrapped	8 Saw cut	11 None (open hole)	
1 Continuous slot	3 Mill slot	6 Wire wrapped	9 Drilled holes	
2 Louvered shutter	4 Key punched	7 Torch cut	10 Other (specify)	
SCREEN-PERFORATED INTERVALS:	From	ft. to	<u>32</u> ft. From	ft. to
GRAVEL PACK INTERVALS:	From	ft. to	<u>32</u> ft. From	ft. to

6 GROUT MATERIAL:	1 Neat cement	2 Cement grout	3 Bentonite	4 Other
Grout Intervals:	From	ft. to	<u>16</u> ft. From	<u>0</u> ft. to
What is the nearest source of possible contamination:	1 Septic tank	4 Lateral lines	7 Pit privy	10 Livestock pens
2 Sewer lines	5 Cess pool	8 Sewage lagoon	11 Fuel storage	14 Abandoned water well
3 Watertight sewer lines	6 Seepage pit	9 Feedyard	12 Fertilizer storage	15 Oil well/Gas well
Direction from well?	<u>unknown - in manufacturing area</u>			16 Other (specify below)
				13 Insecticide storage
				How many feet?

FROM	TO	LITHOLOGIC LOG	FROM	TO	PLUGGING INTERVALS
<u>0</u>	<u>5</u>	<u>DK brn, silty clay</u>			
<u>5</u>	<u>7.5</u>	<u>Tan silty clay</u>			
<u>7.5</u>	<u>9.5</u>	<u>Tan silty clay</u>			
<u>9.5</u>	<u>17</u>	<u>Lt gray with shale</u>			
<u>17</u>	<u>32</u>	<u>DK gray shale</u>			

7 CONTRACTOR'S OR LANDOWNER'S CERTIFICATION: This water well was (1) constructed, (2) reconstructed, or (3) plugged under my jurisdiction and was completed on (mo/day/year)	<u>11-13-96</u>	and this record is true to the best of my knowledge and belief. Kansas
Water Well Contractor's License No.	<u>581</u>	This Water Well Record was completed on (mo/day/yr)
under the business name of	<u>Layne Western</u>	by (signature) <u>Steve Mitchell</u>