


MW5

<b>1 LOCATION OF WATER WELL:</b> County: Sumner	Fraction NW¼ NE¼ SE¼ SE¼	Section Number 26	Township Number T 31 S	Range Number 1 <input type="checkbox"/> E <input checked="" type="checkbox"/> W
--	-----------------------------	----------------------	---------------------------	--

Street/Rural Address of Well Location; if unknown, distance & direction from nearest town or intersection: If at owner's address, check here   
 441 N. West Road, Wellington KS

**Global Positioning Systems (GPS) information:**  
 Latitude: NA (in decimal degrees)  
 Longitude: NA (in decimal degrees)  
 Elevation: NA  
 Horizontal Datum  WGS84,  NAD83,  NAD27  
 Collection Method:  
 GPS unit (Make/model: \_\_\_\_\_)  
 Digital Map/Photo,  Topographic Map  Land Survey  
 Est. Accuracy:  <3 m,  3-5 m,  5-15 m,  >15 m

**2 WATER WELL OWNER:** City of Wellington  
 RR#, St. Address, Box #: 317 S. Washington  
 City, State ZIP Code: Wellington, KS 67152

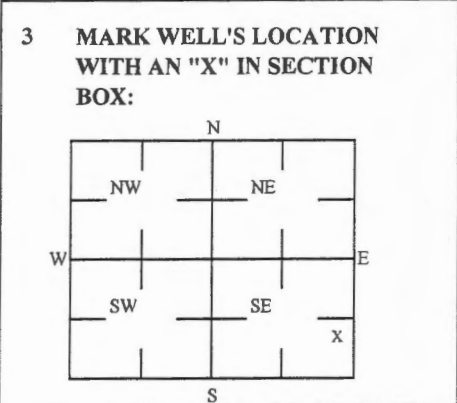

**4 DEPTH OF WELL** 20.04 ft. MW5  
 WELL'S STATIC WATER LEVEL \_\_\_\_\_ ft  
 WELL WAS USED AS:  
 Domestic     Public Water Supply     Dewatering  
 Irrigation     Oil Field Water Supply     Monitoring  
 Feedlot     Domestic (Lawn & Garden)     Injection Well  
 Industrial     Air Conditioning     Other \_\_\_\_\_  
 Was a chemical/bacteriological sample submitted to Department? Yes  No

**5 TYPE OF BLANK CASING USED:**

<input type="checkbox"/> Steel	<input type="checkbox"/> RMP (SR)	<input type="checkbox"/> Wrought	<input type="checkbox"/> Fiberglass	<input type="checkbox"/> Other (Specific below)
<input checked="" type="checkbox"/> PVC	<input type="checkbox"/> ABS	<input type="checkbox"/> Asbestos-Cement	<input type="checkbox"/> Concrete Tile	

Blank casing diameter 2 in.    Was casing pulled? Yes  No     If yes, how much 3 ft  
 Casing high above or below land surface NA in.

**6 GROUT PLUG MATERIAL:**  Neat cement     Cement grout     Bentonite     Other Soil: 0-3 ft

Grout Plug Intervals: From 3 ft to 20.04 ft, From \_\_\_\_\_ ft to \_\_\_\_\_ ft, From \_\_\_\_\_ ft to \_\_\_\_\_ ft.

What is the nearest source of possible contamination:  
 Septic tank     Seepage pit     Fuel storage     Other (specify below) \_\_\_\_\_  
 Sewer lines     Pit privy     Fertilizer storage    \_\_\_\_\_  
 Watertight sewer lines     Sewage lagoon     Insecticide storage    \_\_\_\_\_  
 Lateral lines     Feed yard     Abandoned water well    Direction from well? \_\_\_\_\_  
 Cess pool     Livestock pens     Oil well/Gas well    How many feet? \_\_\_\_\_

FROM	TO	PLUGGING MATERIALS	FROM	TO	PLUGGING MATERIALS
0	3	Soil			
3	20.04	Bentonite			
KDHE ID: Wellington Municipal Airport; U2-096-14649					

**7 CONTRACTOR'S OR LANDOWNER'S CERTIFICATION:** This water well was plugged under my jurisdiction and was completed on (mo/day/year) 2/3/16 and this record is true to the best of my knowledge and belief. Kansas Water Contractor's License No. 757. This Water Well Record was completed on (mo/day/year) 2/10/16 under the business name of Larsen & Associates, Inc. By (signature) \_\_\_\_\_

Send one white copy to Kansas Department of Health & Environment, Geology Section, 1000 SW Jackson Street, Ste. 420, Topeka, KS 66612-1367. Send one copy to WATER WELL OWNER and retain one for your records  
 Visit us at <http://www.kdheks.gov/waterwell/index.html> Telephone 785-296-5524.