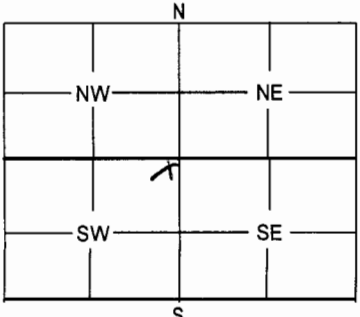


1 LOCATION OF WATER WELL: Fraction Section Number Township Number Range Number  
 County: Barber NE 1/4 NE 1/4 SW 1/4 2 31 11 EW

Distance and direction from nearest town or city street address of well if located within city?

2 WATER WELL OWNER: Klaver Construction Products  
 RR #, St. Address, Box # P.O. Box 152 Board of Agriculture, Division of Water Resources  
 City, State, ZIP Code Kingman, KS 67068 Application Number:

3 MARK WELL'S LOCATION WITH AN "X" IN SECTION BOX:  


4 DEPTH OF WELL 153 ft.  
 WELL'S STATIC WATER LEVEL 50 ft.  
 WELL WAS USED AS:  
 1 Domestic 5 Public Water Supply 9 Dewatering  
 2 Irrigation 6 Oil Field Water Supply 10 Monitoring Well  
 3 Feedlot 7 Domestic (Lawn & Garden) 11 Injection Well  
 4 Industrial 8 Air Conditioning 12 Other

Was a chemical / bacteriological sample submitted to Department? Yes No   
 if yes, mo/day/yr sample was submitted  
 Water Well Disinfected: Yes  No

5 TYPE OF BLANK CASING USED:  
 1 Steel 3 RMP (SR) 5 Wrought 7 Fiberglass 9 Other (Specify below)  
 2 PVC 4 ABS 6 Asbestos-Cement 8 Concrete Tile  
 Blank casing diameter 6 in. Was casing pulled? Yes No   
 Casing height above or below land surface 3 ft B.L.S. in. If yes, how much

6 GROUT PLUG MATERIAL: 1 Neat cement 2 Cement grout 3 Bentonite 4 Other Topsoil  
 Grout Plug Intervals: From 153 ft. to 3 ft B.L.S. ft., From 3 ft B.L.S. ft. to 0 ft., From to ft.  
 What is the nearest source of possible contamination:  
 1 Septic tank 6 Seepage pit 11 Fuel storage 16 Other (specify below)  
 2 Sewer lines 7 Pit privy 12 Fertilizer storage  
 3 Watertight sewer lines 8 Sewage lagoon 13 Insecticide storage  
 4 Lateral lines 9 Feedyard 14 Abandoned water well  
 5 Cess pool 10 Livestock pens 15 Oil well/Gas well  
 Direction from well? 999 How many feet? 999  
 CROP FIELD

FROM	TO	PLUGGING MATERIALS
153'	3'	Bentonite chips, hydrated
3'	0'	Topsoil

7 CONTRACTOR'S OF LANDOWNER'S CERTIFICATION: This water well was plugged under my jurisdiction and was completed on (mo/day/year) 5/28/09 and this record is true to the best of my knowledge and belief. Kansas Water Well Contractor's License No. 665 This Water Well Record was completed on (mo/day/year) 5/29/09 under the business name of Pratt Well Service, Inc.  
 by (signature) *Steven Egler*

INSTRUCTIONS: Use typewriter or ball point pen. Please press firmly and print clearly. Please fill in blanks, underline or circle the correct answers. Send top three copies to Kansas Department of Health and Environment, Bureau of Water, Geology Section, 1 000 SW Jackson St., Ste. 420, Topeka, Kansas 66612-1367. Telephone: 785/296-5522. Send one to Water Well Owner and retain one for your records.