

WATER WELL RECORD


Form WWC-5

Division of Water Resources App. No.

1 LOCATION OF WATER WELL: County: Barber Fraction NW NW 1/4 SW Section Number 20 Township No. T 31 S Range Number R 11 E

Street/Rural Address of Well Location; if unknown, distance & direction from nearest town or intersection: 1 E 3 N, Medicine Lodge, KS Global Positioning System (GPS) information: Latitude: Longitude: Elevation: Datum: Collection Method:

2 WATER WELL OWNER: Ivan Watkins RR#, Street Address, Box #: 4380 NE Isabel Rd City, State, ZIP Code: Medicine Lodge, KS 67604

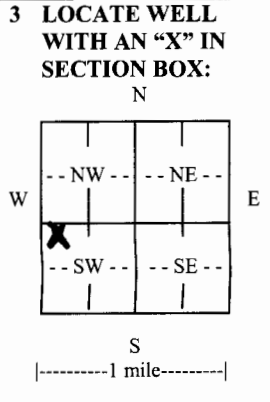

3 LOCATE WELL WITH AN 'X' IN SECTION BOX: 4 DEPTH OF COMPLETED WELL: Depth(s) Groundwater Encountered (1) 8 1/2 ft. (2) 9 ft. (3) 9 ft. WELL'S STATIC WATER LEVEL: 8 1/2 ft. below land surface measured on mo/day/yr. 9-5-12 Pump test data: Well water was ... ft. after ... hours pumping ... gpm EST. YIELD: 20 gpm Well water was ... ft. after ... hours pumping ... gpm Bore Hole Diameter: 9 in. to ... ft., and ... in. to ... ft. WELL WATER TO BE USED AS: [X] Domestic [] Feedlot [] Oil field water supply [] Dewatering [] Other (Specify below) [] Irrigation [] Industrial [] Domestic-lawn & garden [] Monitoring well Was a chemical/bacteriological sample submitted to Department? [] Yes [X] No If yes, mo/day/yr sample was submitted. Water well disinfected? [X] Yes [] No

5 TYPE OF CASING USED: [] Steel [X] PVC [] Other CASING JOINTS: [X] Glued [] Clamped [] Welded [] Threaded Casing diameter: 5 in. to 6.3 ft., Diameter: 18 in. to 160 lbs./ft., Wall thickness or gauge No. TYPE OF SCREEN OR PERFORATION MATERIAL: [] Steel [] Stainless Steel [X] PVC [] Other (Specify) [] Brass [] Galvanized Steel [] None used (open hole) SCREEN OR PERFORATION OPENINGS ARE: [] Continuous slot [] Mill slot [] Gauze wrapped [] Torch cut [] Drilled holes [] None (open hole) [] Louvered shutter [] Key punched [] Wire wrapped [X] Saw cut [] Other (specify) SCREEN-PERFORATED INTERVALS: From 42 ft. to 6.3 ft., From ... ft. to ... ft. GRAVEL PACK INTERVALS: From 23 ft. to 6.3 ft., From ... ft. to ... ft.

6 GROUT MATERIAL: [] Neat cement [] Cement grout [X] Bentonite [] Other Grout Intervals: From 3 ft. to 23 ft., From ... ft. to ... ft., From ... ft. to ... ft. What is the nearest source of possible contamination: [] Septic tank [X] Lateral lines [] Pit privy [] Livestock pens [] Insecticide storage [] Other (specify below) [] Sewer lines [] Cesspool [] Sewage lagoon [] Fuel storage [] Abandoned water well [] Watertight sewer lines [] Seepage pit [] Feedyard [] Fertilizer storage [] Oil well/gas well Direction from well: E Distance from well: 500'

Table with columns: FROM, TO, LITHOLOGIC LOG, FROM, TO, LITHO. LOG (cont.) or PLUGGING INTERVALS. Handwritten entries: 0-3 Soil, 3-8 Sand, 8-42 Brown Clay & Mud, 42-62 Dirty Silty Sand, 62-63 Red Shell.

7 CONTRACTOR'S OR LANDOWNER'S CERTIFICATION: This water well was [X] constructed, [] reconstructed, or [] plugged under my jurisdiction and was completed on (mo/day/year) 9-5-12 and this record is true to the best of my knowledge and belief. Kansas Water Well Contractor's License No. 140 This Water Well Record was completed on (mo/day/year) 9-29-12 under the business name of Lyman's Inc by (signature) [Signature]

INSTRUCTIONS: Use typewriter or ballpoint pen. PLEASE PRESS FIRMLY and PRINT clearly. Please fill in blanks and check the correct answers. Send three copies (white, blue, pink) to Kansas Department of Health and Environment, Bureau of Water, Geology Section, 1000 SW Jackson St., Suite 420, Topeka, Kansas 66612-1367. Telephone 785-296-5524. Send one copy to WATER WELL OWNER and retain one for your records. Include fee of \$5.00 for each constructed well. Visit us at http://www.kdheks.gov/waterwell/index.html.