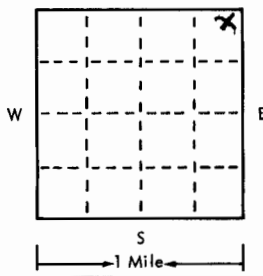
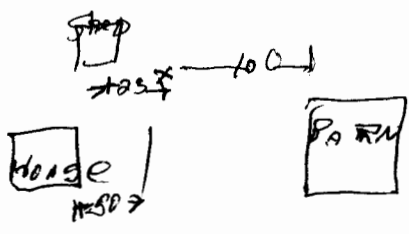


USE TYPEWRITER OR BALL POINT PEN-PRESS FIRMLY, PRINT CLEARLY.

WATER WELL RECORD  
KSA 82a-1201-1215

T R EW sec 1/4 1/4 1/4 No.

Kansas State Dept. Of Health  
(Water Well Contractors)  
Forbes-Bldg. 740  
Topeka, Kansas 66620

<b>X</b> 1 Location of well:	County <u>Barber</u>	Township name	Fraction <u>WENE NE</u>	Section number <u>27</u>	Town number <u>31</u>	Range number <u>12 W</u>		
Distance and direction from nearest town or city: <del>Barber</del> Street address of well location if in city: <u>Med Hedge 2W 8N</u>			3 Owner of well: <u>Fred STRICTLAND</u> Address: <u>302 W2 ML</u>					
Locate with "X" in section below: N  W E S 1 Mile			4 Well depth: <u>43</u> ft. Date of completion <u>6-3-76</u> Well diameter <u>8</u> in.			5 <input type="checkbox"/> Cable tool <input checked="" type="checkbox"/> Rotary <input type="checkbox"/> Driven <input type="checkbox"/> Dug <input type="checkbox"/> Hollow rod <input type="checkbox"/> Jetted <input type="checkbox"/> Bored <input type="checkbox"/> Reverse rotary		
Sketch map: 			6 Use: <input checked="" type="checkbox"/> Domestic <input type="checkbox"/> Public supply <input type="checkbox"/> Industry <input type="checkbox"/> Irrigation <input type="checkbox"/> Air conditioning <input type="checkbox"/> Commercial <input type="checkbox"/> Test well <input type="checkbox"/>					
2 Type and color of material			7 Casing: Material <u>PVC</u> Height: above/below Threaded <input type="checkbox"/> Welded <input checked="" type="checkbox"/> Surface <u>NA</u> in. Diam. <u>4</u> Weight <u>NA</u> lbs./ft. <u>4</u> in. to <u>43</u> ft. depth Drive shoe? <input type="checkbox"/> Yes <input checked="" type="checkbox"/> No			8 Screen: Manufacturer <u>Peerless</u> Type <u>PVC</u> Dia. <u>4</u> Slot/gauze <u>0.35</u> Length <u>3</u> Set between <u>31</u> ft. and <u>36</u> ft. Fittings: <u>1 DN</u> Gravel pack <input checked="" type="checkbox"/> Yes <input type="checkbox"/> No Size range of material <u>    </u>		
			From To			9 Static water level: <u>22</u> ft. below land surface Date <u>6-3-76</u>		
Soil 0 4			10 Pumping level below land surfaces: ft. after    hrs. pumping    g.p.m. ft. after    hrs. pumping    g.p.m. Estimated maximum yield <u>20</u> g.p.m.			11 Water sample submitted: <input type="checkbox"/> Yes <input checked="" type="checkbox"/> No Date <u>    </u>		
Med Sand 4 36			12 Well head completion: <input checked="" type="checkbox"/> Pitless adapter <u>12</u> inches above grade			13 Well grouted? <input checked="" type="checkbox"/> Yes <input type="checkbox"/> No <input checked="" type="checkbox"/> Neat cement <input type="checkbox"/> Bentonite <input type="checkbox"/> Depth: From <u>3</u> ft. to <u>15</u> ft.		
Clay 36 37			14 Nearest source of possible contamination: ft. <u>100</u> Direction <u>E</u> Type <u>PARN</u> Well disinfected upon completion? <input checked="" type="checkbox"/> Yes <input type="checkbox"/> No			15 Pump: <input checked="" type="checkbox"/> Not installed Manufacturer's name <u>    </u> Model number <u>    </u> HP <u>    </u> Volts <u>    </u> Length of drop pipe <u>    </u> ft. capacity <u>    </u> g.m.p. Type: <input type="checkbox"/> Submersible <input type="checkbox"/> Turbine <input type="checkbox"/> Jet <input type="checkbox"/> Reciprocating <input type="checkbox"/> Centrifugal <input type="checkbox"/> Other		
Fine Sand 37 40			16 Remarks: elevation <u>customer well set slot</u>			17 Water well contractor's certification: This well was drilled under my jurisdiction and this report is true to the best of my knowledge and belief. <u>LYMAN BROS 140</u> Business name License No. Address <u>MLD</u> Signed <u>    </u> Date <u>6-3-76</u> Authorized representative		
Shale 41 43			(use a second sheet if needed)					

31 12W 27 WENE NE