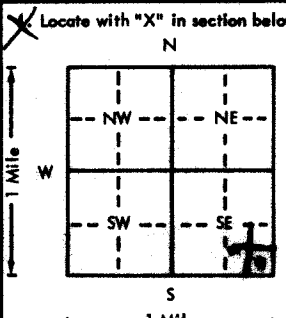


USE TYPEWRITER OR BALL POINT PEN-PRESS FIRMLY, PRINT CLEARLY.

WATER WELL RECORD
KSA 82a-1201-1215

Kansas Department of Health and Environment-Division of Environment
(Water well Contractors)
Topeka, Kansas 66620

1. Location of well:		County Barber	Fraction SE 1/4 SE 1/4 SE 1/4	Section number 51	Township number T 31 S R 21 W	Range number 21 W	<input checked="" type="checkbox"/> E/W
2. Distance and direction from nearest town or city: Street address of well location if in city: 4W LN ML				3. Owner of well: Roger Simpson R.R. or street: City, state, zip code: Medicine Lodge 67104			
<input checked="" type="checkbox"/> Locate with "X" in section below: 		Sketch map:		6. Bore hole dia. 8 in. Completion date _____ <input checked="" type="checkbox"/> Well depth 66 ft. 5-18-78 7. Cable tool <input checked="" type="checkbox"/> Rotary _____ Driven _____ Dug _____ Hollow rod _____ Jetted _____ Bored _____ Reverse rotary _____ 8. Use: _____ Domestic _____ Public supply _____ Industry _____ Irrigation _____ Air conditioning <input checked="" type="checkbox"/> Stock _____ _____ Other _____ 9. Casing: Material _____ Weight: _____ below Threaded _____ Welded _____ Surface _____ in. RMP _____ PVC <input checked="" type="checkbox"/> Weight 177 lbs./ft. Dia. 4 in. to 58 ft. depth; Wall Thickness: inches or Dia. _____ in. to _____ ft. depth; gage No. 187			
5. Type and color of material		From	To	10. Screens: Manufacturer's name _____ Pumper Type _____ PVC Dia. 4 Slot/gauze 030 Length 10 Set between 48 ft. and 58 ft. _____ ft. and _____ ft. Gravel pack? <input checked="" type="checkbox"/> Size range of material 20-40			
sand clay med silty sand		0	14	11. Static water level: _____ no./day/yr. 10 ft. below land surface Date 5-18-78 12. Pumping level below land surfaces: _____ ft. after _____ hrs. pumping _____ g.p.m. _____ ft. after _____ hrs. pumping _____ g.p.m. Estimated maximum yield 20 g.p.m. 13. Water sample submitted: _____ no./day/yr. Yes <input checked="" type="checkbox"/> No _____ Date _____			
to 10 ft. 16. Nearest source of possible contamination: Pasture ft. _____ Direction _____ Type _____ Well disinfected upon completion? <input checked="" type="checkbox"/> Yes _____ No _____			
17. Pump: <input checked="" type="checkbox"/> Not installed Manufacturer's name _____ Model number _____ HP _____ Volts _____ Length of drop pipe _____ ft. capacity _____ g.p.m. Type: _____ Submersible _____ Turbine _____ Jet _____ Reciprocating _____ Centrifugal _____ Other _____				18. Elevation: Topography: <input type="checkbox"/> Hill <input checked="" type="checkbox"/> Slope <input type="checkbox"/> Upland <input type="checkbox"/> Valley			
19. Remarks: Slab to be poured by customer		(Use a second sheet if needed)		20. Water well contractor's certification: This well was drilled under my jurisdiction and this report is true to the best of my knowledge and belief. Lyman Bros 140 Business name _____ License No. _____ Address ML Signed <i>ML Lyman</i> _____ Date 5-22-78 Authorized representative			

Forward the white, blue and pink copies to the Department of Health and Environment

Form WWC-5

12
 31
 31
 SE
 NE
 SE
 SE