

WATER WELL RECORD

Form WWC-5

Division of Water Resources; App. No.


1 LOCATION OF WATER WELL: County: <u>Barber</u>	Fraction <u>SW 1/4 NW 1/4 SE 1/4</u>	Section Number <u>25</u>	Township Number <u>T 31 S</u>	Range Number <u>R 13 E/W</u>
---	--------------------------------------	--------------------------	-------------------------------	------------------------------

Distance and direction from nearest town or city street address of well if located within city? 6 W Medicine Lodge KS

Global Positioning Systems (decimal degrees, min. of 4 digits)
 Latitude: _____
 Longitude: _____
 Elevation: _____
 Datum: _____

2 WATER WELL OWNER:
 RR#, St. Address, Box # : Alan Kimball 3002 NW Mingosa
 City, State, ZIP Code : Medicine Lodge KS 67564

Collection Method: _____

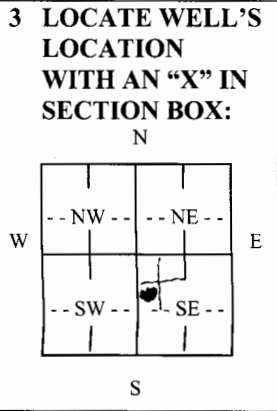

4 DEPTH OF COMPLETED WELL 65 ft.

Depth(s) Groundwater Encountered (1)..... 12 ft. (2)..... ft. (3)..... ft.

WELL'S STATIC WATER LEVEL..... 12 ft. below land surface measured on mo/day/yr. 3-6-06

Pump test data: Well water was.....ft. after..... hours pumping..... gpm
 Est. Yield.....gpm: Well water was.....ft. after..... hours pumping..... gpm

WELL WATER TO BE USED AS: 5 Public water supply 8 Air conditioning 11 Injection well
 1 Domestic 3 Feedlot 6 Oil field water supply 9 Dewatering 12 Other (Specify below)
 2 Irrigation 4 Industrial 7 Domestic (lawn & garden) 10 Monitoring well

Was a chemical/bacteriological sample submitted to Department? Yes No ; If yes, mo/day/yrs
 Sample was submitted..... Water well disinfected? Yes No

5 TYPE OF CASING USED:

1 Steel	3 RMP (SR)	5 Wrought Iron	8 Concrete tile	CASING JOINTS: Glued <input checked="" type="checkbox"/> Clamped.....
2 PVC	4 ABS	6 Asbestos-Cement	9 Other (specify below)	Welded.....
		7 Fiberglass		Threaded.....

Blank casing diameter 5 in. to ft., Diameter. in. to ft., Diameter in. to ft.
 Casing height above land surface..... 24 in., Weight..... 160 lbs./ft. Wall thickness or guage No.

TYPE OF SCREEN OR PERFORATION MATERIAL:

1 Steel	3 Stainless Steel	5 Fiberglass	7 PVC	9 ABS	11 Other (Specify)
2 Brass	4 Galvanized Steel	6 Concrete tile	8 RM (SR)	10 Asbestos-Cement	12 None used (open hole)

SCREEN OR PERFORATION OPENINGS ARE:

1 Continuous slot	3 Mill slot	5 Guazed wrapped	7 Torch cut	9 Drilled holes	11 None (open hole)
2 Louvered shutter	4 Key punched	6 Wire wrapped	8 Saw Cut	10 Other (specify)	

SCREEN-PERFORATED INTERVALS: From..... 46 ft. to 49 ft., From..... 53 ft. to 65 ft.
 From..... ft. to ft., From..... ft. to ft.

GRAVEL PACK INTERVALS: From..... 20 ft. to 65 ft., From..... ft. to ft.
 From..... ft. to ft., From..... ft. to ft.

6 GROUT MATERIAL: 1 Neat cement 2 Cement grout 3 Bentonite 4 Other

Grout Intervals: From..... 0 ft. to 20 ft., From..... ft. to ft., From..... ft. to ft.

What is the nearest source of possible contamination:

1 Septic tank	4 Lateral lines	7 Pit privy	10 Livestock pens	13 Insecticide Storage	16 Other (specify below)
2 Sewer lines	5 Cess pool	8 Sewage lagoon	11 Fuel storage	14 Abandoned water well	
3 Watertight sewer lines	6 Sepage pit	9 Feedyard	12 Fertilizer Storage	15 Oil well/gas well	

Direction from well? S How many feet? 600

FROM	TO	LITHOLOGIC LOG	FROM	TO	PLUGGING INTERVALS
0	2	Sandy Spill	62	65	Red Shale
2	4	Brown Clay			
4	12	Red Clay			
12	22	Fine Sand			
22	24	Sand			
24	32	sand some Med.			
32	46	Dirty Sand			
46	49	Sand			
49	53	Fine Sand			
53	62	Sand			

7 CONTRACTOR'S OR LANDOWNER'S CERTIFICATION: This water well was (1) constructed, (2) reconstructed, or (3) plugged under my jurisdiction and was completed on (mo/day/year) 3-6-06 and this record is true to the best of my knowledge and belief.

Kansas Water Well Contractor's License No. 140 This Water Well Record was completed on (mo/day/year)

under the business name of Lyman's Inc by (signature) Alan Lyman

INSTRUCTIONS: Use typewriter or ball point pen. PLEASE PRESS FIRMLY and PRINT clearly. Please fill in blanks, underline or circle the correct answers. Send top three copies to Kansas Department of Health and Environment, Bureau of Water, Geology Section, 1000 SW Jackson St., Suite 420, Topeka, Kansas 66612-1367. Telephone 785-296-5522. Send one to WATER WELL OWNER and retain one for your records. Fee of \$5.00 for each constructed well. Visit us at <http://www.kdhe.state.ks.us/geo/waterwells>.