


1 LOCATION OF WATER WELL: County: COMANCHE Fraction: NE 1/4 SW 1/4 NE 1/4 Section Number: 19 Township Number: T 31 S Range Number: R 17 E/W

Distance and direction from nearest town or city street address of well if located within city?
Community Center

2 WATER WELL OWNER: CITY OF WILMORE
RR#, St. Address, Box #: _____
City, State, ZIP Code: TERRY LITWILLER Mayor Board of Agriculture, Division of Water Resources
Application Number: _____

3 LOCATE WELL'S LOCATION WITH AN "X" IN SECTION BOX:

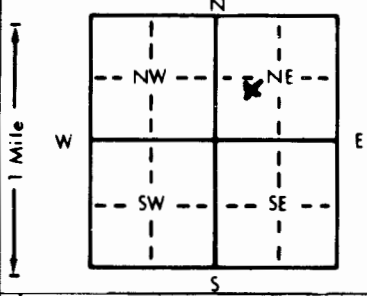

4 DEPTH OF COMPLETED WELL: 138 ft. ELEVATION: _____
Depth(s) Groundwater Encountered: 1. 75 ft. 2. _____ ft. 3. _____ ft.
WELL'S STATIC WATER LEVEL: 60 ft. below land surface measured on mo/day/yr _____
Pump test data: Well water was _____ ft. after _____ hours pumping _____ gpm
Est. Yield: 20 gpm Well water was _____ ft. after _____ hours pumping _____ gpm
Bore Hole Diameter: 10 in. to 138 ft., and _____ in. to _____ ft.
WELL WATER TO BE USED AS:
1 Domestic 3 Feedlot 6 Oil field water supply 9 Dewatering 11 Injection well
2 Irrigation 4 Industrial 7 Lawn and garden only 10 Monitoring well 12 Other (Specify below) _____
Was a chemical/bacteriological sample submitted to Department? Yes _____ No ; If yes, mo/day/yr sample was submitted _____
Water Well Disinfected? Yes No _____

5 TYPE OF BLANK CASING USED:
1 Steel 3 RMP (SR) 5 Wrought iron 8 Concrete tile CASING JOINTS: Glued Clamped _____
2 PVC 4 ABS 7 Fiberglass Welded _____
Blank casing diameter: 5 in. to _____ ft., Dia. _____ in. to _____ ft., Dia. _____ in. to _____ ft.
Casing height above land surface: 24 in., weight 237 lbs./ft. Wall thickness or gauge No. 3/4

TYPE OF SCREEN OR PERFORATION MATERIAL:
1 Steel 3 Stainless steel 5 Fiberglass 8 RMP (SR) 10 Asbestos-cement
2 Brass 4 Galvanized steel 6 Concrete tile 9 ABS 11 Other (specify) _____
SCREEN OR PERFORATION OPENINGS ARE:
1 Continuous slot 3 Mill slot 5 Gauzed wrapped 8 Saw cut 11 None (open hole)
2 Louvered shutter 4 Key punched 6 Wire wrapped 9 Drilled holes 10 Other (specify) 200 lb per ft

SCREEN-PERFORATED INTERVALS: From 115 ft. to 135 ft., From _____ ft. to _____ ft.
GRAVEL PACK INTERVALS: From 20 ft. to 138 ft., From _____ ft. to _____ ft.
From Top ft. to _____ ft., From _____ ft. to _____ ft.

6 GROUT MATERIAL: 1 Neat cement 2 Cement Grout 3 plug 4 Other
Grout Intervals: From 0 ft. to 20 ft., From 60 ft. to 75 ft., From _____ ft. to _____ ft.

What is the nearest source of possible contamination:
1 Septic tank 4 Lateral lines 7 Pit privy 10 Livestock pens 14 Abandoned water well
2 Sewer lines 5 Cess pool 8 Sewage lagoon 11 Fuel storage 15 Oil well/Gas well
3 Watertight sewer lines 6 Seepage pit 9 Feedyard 12 Fertilizer storage 16 Other (specify below) _____

Direction from well? North East How many feet? 150'

FROM	TO	LITHOLOGIC LOG	FROM	TO	PLUGGING INTERVALS
0	60	SAND CLAY MIX			
60	75	CLAY	60	75	NO/E PLUG
75	110	FINE SAND			
110	135	FINE SAND WITH COARSE 1/8"			
135	138	CLAY			

7 CONTRACTOR'S OR LANDOWNER'S CERTIFICATION: This water well was (1) constructed, (2) reconstructed, or (3) plugged under my jurisdiction and was completed on (mo/day/year) 5-4-98 and this record is true to the best of my knowledge and belief. Kansas Water Well Contractor's License No. 411 This Water Well Record was completed on (mo/day/yr) 5-5-98 under the business name of LEH'S WATER WELL SERVICE by (signature) Ron Zell

OFFICE USE ONLY
T
R
EW
SEC.