

WATER WELL RECORD

Form WWC-5

Division of Water Resources App. No.


[Empty box]

1 LOCATION OF WATER WELL: County: Comanche Fraction 1/4 SE 1/4 SE 1/4 SE 1/4 Section Number 15 Township No. T 31 S Range Number R 17 [ ] E [X] W

Street/Rural Address of Well Location; if unknown, distance & direction from nearest town or intersection: If at owner's address, check here [ ]. From Wilmore, 1/4 mile then 1/4 mile north on 20 rd.

Global Positioning System (GPS) information: Latitude: ... Longitude: ... Elevation: ... Datum: [ ] WGS 84, [ ] NAD 83, [ ] NAD 27 Collection Method: [ ] GPS unit, [ ] Digital Map/Photo, [ ] Topographic Map, [ ] Land Survey Est. Accuracy: [ ] <3 m, [ ] 3-5 m, [ ] 5-15 m, [ ] >15 m

2 WATER WELL OWNER: Craig Bunnell RR#, Street Address, Box #: 12049 104 Rd. City, State, ZIP Code: Dodge City, KS 67801

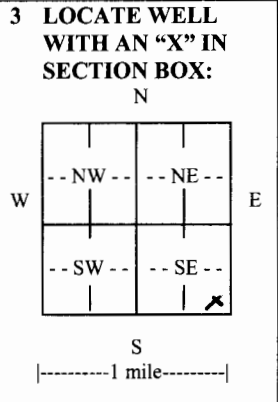

3 LOCATE WELL WITH AN "X" IN SECTION BOX: 4 DEPTH OF COMPLETED WELL 70 ft. Depth(s) Groundwater Encountered (1) ... (2) ... (3) ... WELL'S STATIC WATER LEVEL 36 ft. below land surface measured on mo/day/yr. 2/23/12 Pump test data: Well water was ... EST. YIELD ... Bore Hole Diameter 7 7/8 in. to 70 ft. ... WELL WATER TO BE USED AS: [X] Domestic, [ ] Feedlot, [ ] Oil field water supply, [ ] Dewatering, [ ] Other (Specify below) Was a chemical/bacteriological sample submitted to Department? [ ] Yes [X] No If yes, mo/day/yr sample was submitted ... Water well disinfected? [X] Yes [ ] No

5 TYPE OF CASING USED: [ ] Steel [X] PVC [ ] Other CASING JOINTS: [X] Glued [ ] Clamped [ ] Welded [ ] Threaded Casing diameter 3 in. to 70 ft., Diameter ... in. to ... ft., Diameter ... in. to ... ft. Casing height above land surface 12 in., Weight ... lbs./ft., Wall thickness or gauge No. SDR 21 TYPE OF SCREEN OR PERFORATION MATERIAL: [ ] Steel [ ] Stainless Steel [X] PVC [ ] Other (Specify) [ ] Brass [ ] Galvanized Steel [ ] None used (open hole) SCREEN OR PERFORATION OPENINGS ARE: [ ] Continuous slot [X] Mill slot [ ] Gauze wrapped [ ] Torch cut [ ] Drilled holes [ ] None (open hole) [ ] Louvered shutter [ ] Key punched [ ] Wire wrapped [ ] Saw cut [ ] Other (specify) SCREEN-PERFORATED INTERVALS: From 50 ft. to 70 ft., From ... ft. to ... ft. GRAVEL PACK INTERVALS: From 20 ft. to 70 ft., From ... ft. to ... ft.

6 GROUT MATERIAL: [ ] Neat cement [ ] Cement grout [X] Bentonite [ ] Other Grout Intervals: From 0 ft. to 30 ft., From ... ft. to ... ft., From ... ft. to ... ft. What is the nearest source of possible contamination: [ ] Septic tank [ ] Lateral lines [ ] Pit privy [ ] Livestock pens [ ] Insecticide storage [X] Other (specify below) [ ] Sewer lines [ ] Cesspool [ ] Sewage lagoon [ ] Fuel storage [ ] Abandoned water well [ ] Watertight sewer lines [ ] Seepage pit [ ] Feedyard [ ] Fertilizer storage [ ] Oil well/gas well In. Pasture Direction from well ... Distance from well ...

Table with columns: FROM, TO, LITHOLOGIC LOG, FROM, TO, LITHO. LOG (cont.) or PLUGGING INTERVALS. Row 1: 0, 20, Tan Clay. Row 2: 20, 70, Med. Sand.

7 CONTRACTOR'S OR LANDOWNER'S CERTIFICATION: This water well was [X] constructed, [ ] reconstructed, or [ ] plugged under my jurisdiction and was completed on (mo/day/year) 2/23/12 and this record is true to the best of my knowledge and belief. Kansas Water Well Contractor's License No. 533 This Water Well Record was completed on (mo/day/year) 2/25/13 under the business name of Jantzen Water Well by (signature)

INSTRUCTIONS: Use typewriter or ball point pen. PLEASE PRESS FIRMLY and PRINT clearly. Please fill in blanks and check the correct answers. Send three copies (white, blue, pink) to Kansas Department of Health and Environment, Bureau of Water, Geology Section, 1000 SW Jackson St., Suite 420, Topeka, Kansas 66612-1367. Telephone 785-296-5524. Send one copy to WATER WELL OWNER and retain one for your records. Include fee of \$5.00 for each constructed well. Visit us at http://www.kdheks.gov/waterwell/index.html.