


1 LOCATION OF WATER WELL: Fraction SE 1/4 SE 1/4 NW 1/4 Section Number 19 Township Number T 31 S Range Number R 17 E  
 County: COMANCHE

Distance and direction from nearest town or city street address of well if located within city?  
North PART OF WILMORE WEST SIDE OF MAIN ROAD

2 WATER WELL OWNER: BILL EDWARDS  
 RR#, St. Address, Box #: WILMORE, KANSAS  
 City, State, ZIP Code: WILMORE, KANSAS  
 Board of Agriculture, Division of Water Resources  
 Application Number:

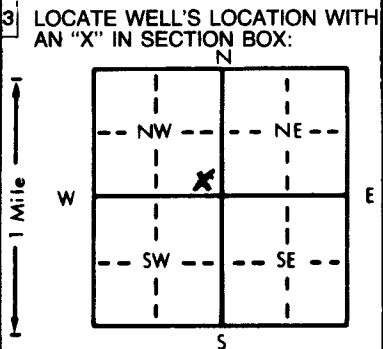

4 DEPTH OF COMPLETED WELL: 65 ft. ELEVATION: 40 ft.  
 Depth(s) Groundwater Encountered 1. 40 ft. 2. 40 ft. 3. 40 ft.  
 WELL'S STATIC WATER LEVEL: 10 ft. below land surface measured on mo/day/yr  
 Pump test data: Well water was 20 gpm after 9 hours pumping  
 Est. Yield 20 gpm: Well water was 65 ft. after 9 hours pumping  
 Bore Hole Diameter: 9 in. to 65 ft., and 65 in. to 65 ft.  
 WELL WATER TO BE USED AS:  
 Domestic 3 Feedlot 6 Oil field water supply 9 Dewatering 12 Other (Specify below)  
 2 Irrigation 4 Industrial 7 Lawn and garden only 10 Observation well  
 Was a chemical/bacteriological sample submitted to Department? Yes.....No.....  
 Water Well Disinfected? Yes  No

5 TYPE OF BLANK CASING USED:  
 1 Steel 3 RMP (SR) 5 Wrought iron 8 Concrete tile CASING JOINTS: Glued  Clamped   
 2 PVC 4 ABS 6 Asbestos-Cement 9 Other (specify below) Welded   
 7 Fiberglass Threaded   
 Blank casing diameter: 5 in. to 40 ft., Dia. 2 3/4 in. to 2 1/4 ft.  
 Casing height above land surface: 18 in., weight 2.37 lbs./ft. Wall thickness or gauge No. 214  
 TYPE OF SCREEN OR PERFORATION MATERIAL:  
 1 Steel 3 Stainless steel 5 Fiberglass 8 RMP (SR) 10 Asbestos-cement  
 2 Brass 4 Galvanized steel 6 Concrete tile 9 ABS 11 Other (specify)   
 12 None used (open hole)  
 SCREEN OR PERFORATION OPENINGS ARE:  
 1 Continuous slot 3 Mill slot 5 Gauzed wrapped 8 Saw cut 11 None (open hole)  
 2 Louvered shutter 4 Key punched 6 Wire wrapped 9 Drilled holes  
 7 Torch cut 10 Other (specify)   
 SCREEN-PERFORATED INTERVALS: From 40 ft. to 60 ft., From  ft. to  ft.  
 From  ft. to  ft., From  ft. to  ft.  
 GRAVEL PACK INTERVALS: From 20 ft. to 65 ft., From  ft. to  ft.  
 From  ft. to  ft., From  ft. to  ft.

6 GROUT MATERIAL: 1 Neat cement 2 Cement grout 3 Bentonite 4 Other   
 Grout Intervals: From 0 ft. to 20 ft., From  ft. to  ft., From  ft. to  ft.  
 What is the nearest source of possible contamination:  
 1 Septic tank 4 Lateral lines 7 Pit privy 10 Livestock pens 14 Abandoned water well  
 2 Sewer lines 5 Cess pool 8 Sewage lagoon 11 Fuel storage 15 Oil well/Gas well  
 3 Watertight sewer lines 6 Seepage pit 9 Feedyard 12 Fertilizer storage 16 Other (specify below)  
 13 Insecticide storage  
 Direction from well? NE How many feet? 60'

FROM	TO	LITHOLOGIC LOG	FROM	TO	LITHOLOGIC LOG
<u>0</u>	<u>10</u>	<u>BLACK SOIL</u>			
<u>11</u>	<u>22</u>	<u>DARK CLAY</u>			
<u>23</u>	<u>40</u>	<u>LIGHT COLOR CLAY</u>			
<u>41</u>	<u>40</u>	<u>SAND GRAVEL</u>			
<u>61</u>	<u>65</u>	<u>RED CLAY</u>			

7 CONTRACTOR'S OR LANDOWNER'S CERTIFICATION: This water well was (1) constructed, (2) reconstructed, or (3) plugged under my jurisdiction and was completed on (mo/day/year) 5-26-87 and this record is true to the best of my knowledge and belief. Kansas Water Well Contractor's License No. 411 This Water Well Record was completed on (mo/day/yr) 5-29-87 under the business name of LEHI WATER WELL by (signature) Ron Lehl  
 INSTRUCTIONS: Use typewriter or ball point pen, PLEASE PRESS FIRMLY and PRINT clearly. Please fill in blanks, underline or circle the correct answers. Send top three copies to Kansas Department of Health and Environment, Division of Environment, Environmental Geology Section, Topeka, KS 66620. Send one to WATER WELL OWNER and retain one for your records.

OFFICE USE ONLY  
T  
R  
EW  
SEC.  
1/4  
1/4  
1/4