


1 LOCATION OF WATER WELL: County: Comanche Fraction C 1/4 NE 1/4 NW 1/4 Section Number 18 Township Number T 31 S Range Number R 18W EW

Distance and direction from nearest town or city street address of well if located within city? 6 N of Coldwater, Kansas

2 WATER WELL OWNER: Bill Miller H-30, Inc. RR#, St. Address, Box #: Coldwater, KS 251 N. Water, Suite 10 City, State, ZIP Code: 67029 Wichita, KS 67202 Miller #1 Board of Agriculture, Division of Water Resources Application Number: T88-445

3 LOCATE WELL'S LOCATION WITH AN "X" IN SECTION BOX:

4 DEPTH OF COMPLETED WELL: 275 ft. ELEVATION: Unknown. Depth(s) Groundwater Encountered: 1. 160 ft. 2. 3. WELL'S STATIC WATER LEVEL: 160 ft. below land surface measured on mo/day/yr 8/12/88. Pump test data: Well water was ... ft. after ... hours pumping ... gpm. Est. Yield: 60 gpm. Well water was ... ft. after ... hours pumping ... gpm. Bore Hole Diameter: 8 in. to 275 ft., and ... in. to ... ft. WELL WATER TO BE USED AS: 5 Public water supply 8 Air conditioning 11 Injection well 1 Domestic 3 Feedlot 6 Oil field water supply 9 Dewatering 12 Other (Specify below) 2 Irrigation 4 Industrial 7 Lawn and garden only 10 Observation well. Was a chemical/bacteriological sample submitted to Department? Yes... No... X...; If yes, mo/day/yr sample was submitted. Water Well Disinfected? Yes No X

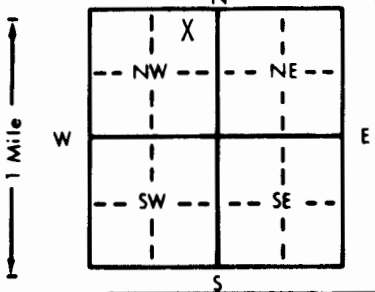

5 TYPE OF BLANK CASING USED: 1 Steel 3 RMP (SR) 5 Wrought iron 8 Concrete tile CASING JOINTS: Glued X Clamped Welded Threaded. 2 PVC 4 ABS 7 Fiberglass 9 Other (specify below)

Blank casing diameter: 5 in. to 255 ft., Dia. 2.8 in. to ... ft., Dia. Casing height above land surface: 12 in., weight 2.8 lbs./ft. Wall thickness or gauge No. Sch. 40

TYPE OF SCREEN OR PERFORATION MATERIAL: 1 Steel 3 Stainless steel 5 Fiberglass 8 RMP (SR) 11 Other (specify) 2 Brass 4 Galvanized steel 6 Concrete tile 9 ABS 12 None used (open hole) 7 PVC 10 Asbestos-cement

SCREEN OR PERFORATION OPENINGS ARE: 1 Continuous slot 3 Mill slot 5 Gauzed wrapped 8 Saw cut 11 None (open hole) 2 Louvered shutter 4 Key punched 6 Wire wrapped 9 Drilled holes 7 Torch cut 10 Other (specify)

SCREEN-PERFORATED INTERVALS: From 255 ft. to 275 ft. GRAVEL PACK INTERVALS: From 20 ft. to 275 ft.

6 GROUT MATERIAL: 1 Neat cement 2 Cement grout 3 Bentonite 4 Other Grout Intervals: From 0 ft. to 20 ft.

What is the nearest source of possible contamination: 1 Septic tank 4 Lateral lines 7 Pit privy 10 Livestock pens 14 Abandoned water well 2 Sewer lines 5 Cess pool 8 Sewage lagoon 11 Fuel storage 15 Oil well/Gas well 3 Watertight sewer lines 6 Seepage pit 9 Feedyard 12 Fertilizer storage 16 Other (specify below) 13 Insecticide storage

Direction from well? South How many feet? 60

LITHOLOGIC LOG table with columns: FROM, TO, LITHOLOGIC LOG, FROM, TO, LITHOLOGIC LOG. Row 1: 275', 5', Neat cement.

7 CONTRACTOR'S OR LANDOWNER'S CERTIFICATION: This water well was (1) constructed, (2) reconstructed, or (3) plugged under my jurisdiction and was completed on (mo/day/year) 9/88 and this record is true to the best of my knowledge and belief. Kansas Water Well Contractor's License No. This Water Well Record was completed on (mo/day/yr) 10/10/88 under the business name of H-30 Drilling, Inc. by (signature) Pam Datche

INSTRUCTIONS: Use typewriter or ball point pen. PLEASE PRESS FIRMLY and PRINT clearly. Please fill in blanks, underline or circle the correct answers. Send top three copies to Kansas Department of Health and Environment, Bureau of Water Protection, Topeka, Kansas 66620-7320, Telephone: 913-862-9360. Send one to WATER WELL OWNER and retain one for your records.

OFFICE USE ONLY T R E/W SEC.