


1 LOCATION OF WATER WELL: County Comanche Fraction SW 1/4 SW 1/4 SW 1/4 Section Number 25 Township Number T 31 S Range Number R 18 E/W

Distance and direction from nearest town or city street address of well if located within city?
2 5 3/4 W. Wilmore Kansas

2 WATER WELL OWNER: Alton Unruh
 RR#, St. Address, Box #: Wilmore Kansas
 City, State, ZIP Code: Wilmore Kansas
 Board of Agriculture, Division of Water Resources
 Application Number:

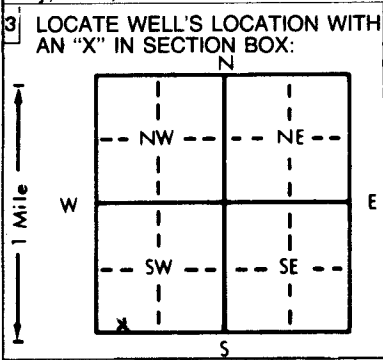

4 DEPTH OF COMPLETED WELL: 220 ft. ELEVATION: _____
 Depth(s) Groundwater Encountered 1. 82 ft. 2. _____ ft. 3. _____ ft.
 WELL'S STATIC WATER LEVEL 82 ft. below land surface measured on mo/day/yr 12-3-80
 Pump test data: Well water was 140 ft. after 1 hours pumping 10 gpm
 Est. Yield 12 gpm. Well water was _____ ft. after _____ hours pumping _____ gpm
 Bore Hole Diameter: 8 3/4 in. to 220 ft., and _____ in. to _____ ft.
 WELL WATER TO BE USED AS:
 5 Public water supply 8 Air conditioning 11 Injection well
 1 Domestic 3 Feedlot 6 Oil field water supply 9 Dewatering 12 Other (specify below)
 2 Irrigation 4 Industrial 7 Lawn and garden only 10 Observation well Pasture
 Was a chemical/bacteriological sample submitted to Department? Yes _____ No X If yes, mo/day/yr sample was submitted
 Water Well Disinfected? Yes X No _____

5 TYPE OF BLANK CASING USED:
 1 Steel 2 PVC 3 RMP (SR) 4 ABS 5 Wrought iron 6 Asbestos-Cement 7 Fiberglass 8 Concrete tile 9 Other (specify below) 10 Asbestos-cement 11 Other (specify) 12 None used (open hole)
 Blank casing diameter 5 in. to 200 ft., Dia _____ in. to _____ ft., Dia _____ in. to _____ ft.
 Casing height above land surface 12 in., weight 1 1/2 lbs./ft. Wall thickness or gauge No. SPR-26
 TYPE OF SCREEN OR PERFORATION MATERIAL:
 1 Steel 2 Brass 3 Stainless steel 4 Galvanized steel 5 Fiberglass 6 Concrete tile 7 PVC 8 RMP (SR) 9 ABS 10 Asbestos-cement 11 Other (specify) 12 None used (open hole)
 SCREEN OR PERFORATION OPENINGS ARE:
 1 Continuous slot 2 Louvered shutter 3 Mill slot 4 Key punched 5 Gauzed wrapped 6 Wire wrapped 7 Torch cut 8 Saw cut 9 Drilled holes 11 None (open hole)
 SCREEN-PERFORATED INTERVALS: From 200 ft. to 220 ft., From _____ ft. to _____ ft., From _____ ft. to _____ ft.
 GRAVEL PACK INTERVALS: From 180 ft. to 220 ft., From _____ ft. to _____ ft., From _____ ft. to _____ ft.

6 GROUT MATERIAL: 1 Neat cement 2 Cement grout 3 Bentonite 4 Other
 Grout Intervals: From 4 ft. to 14 ft., From _____ ft. to _____ ft., From _____ ft. to _____ ft.
 What is the nearest source of possible contamination:
 1 Septic tank 2 Sewer lines 3 Watertight sewer lines 4 Lateral lines 5 Cess pool 6 Seepage pit 7 Pit privy 8 Sewage lagoon 9 Feedyard 10 livestock pens 11 Fuel storage 12 Fertilizer storage 13 Insecticide storage 14 Abandoned water well 15 Oil well/Gas well 16 Other (specify below)
 Direction from well? S. How many feet? 50

FROM	TO	LITHOLOGIC LOG	FROM	TO	LITHOLOGIC LOG
0	2	Top Soil			
2	14	DK. BR. Sandy Clay			
14	20	DK. BR. Clay			
20	32	Sand with Clay STREAKS			
32	106	Sand & GRAVEL			
106	116	Gray Clay			
116	120	Sand & GRAVEL			
120	140	Clay with Sand STREAKS			
140	183	LT. Tan Clay			
183	191	GRAVEL			
191	192	Clay			
192	220	GRAVEL			

7 CONTRACTOR'S OR LANDOWNER'S CERTIFICATION: This water well was (1) constructed, (2) reconstructed, or (3) plugged under my jurisdiction and was completed on (mo/day/year) 12-3-80 and this record is true to the best of my knowledge and belief. Kansas
 Water Well Contractor's License No. 224 This Water Well Record was completed on (mo/day/yr) 7-5-81
 under the business name of Carl Kayse Water Well Serv. by (signature) Carl Kayse

INSTRUCTIONS: Use typewriter or ball point pen, PLEASE PRESS FIRMLY and PRINT clearly. Please fill in blanks, underline or circle the correct answers. Send top three copies to Kansas Department of Health and Environment, Division of Environment, Environmental Geology Section, Topeka, KS 66620. Send one to WATER WELL OWNER and retain one for your records.

OFFICE USE ONLY
T
R
SEC. 25
1/4 SW 1/4 SW 1/4 SW