


1 LOCATION OF WATER WELL: Fraction NW 1/4 NW 1/4 NE 1/4 Section Number 33 Township Number T 31 S Range Number R 18 **(W)**

Distance and direction from nearest town or city street address of well if located within city?
3 East and 2 North of Coldwater, Kansas

2 WATER WELL OWNER: Mr. Roy Boisseau
RR#, St. Address, Box #: RFD Board of Agriculture, Division of Water Resources
City, State, ZIP Code: Coldwater, Kansas 67029 Application Number: -----

3 LOCATE WELL'S LOCATION WITH AN "X" IN SECTION BOX:

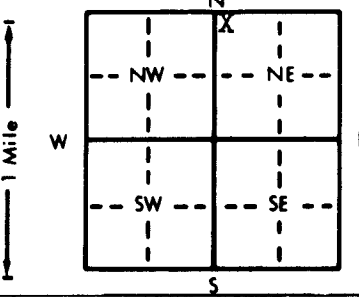

4 DEPTH OF COMPLETED WELL... 160... ft. ELEVATION: Slope.....
Depth(s) Groundwater Encountered 1. Not available ft. 2. ft. 3. ft.
WELL'S STATIC WATER LEVEL ... 82 ... ft. below land surface measured on mo/day/yr Feb. 11, 1987...
Pump test data: Well water was ft. after hours pumping gpm
Est. Yield ... 15 ... gpm: Well water was ft. after hours pumping gpm
Bore Hole Diameter ... 8.9 ... in. to ... 160 ... ft., and ... in. to ... ft.
WELL WATER TO BE USED AS: 5 Public water supply 8 Air conditioning 11 Injection well
XX Domestic 3 Feedlot 6 Oil field water supply 9 Dewatering 12 Other (Specify below)
2 Irrigation 4 Industrial 7 Lawn and garden only 10 Observation well
Was a chemical/bacteriological sample submitted to Department? Yes.....No...XX...; If yes, mo/day/yr sample was submitted
Water Well Disinfected? Yes XX No

5 TYPE OF CASING USED: 5 Wrought iron 8 Concrete tile CASING JOINTS: Glued XX Clamped
1 Steel 3 RMP (SR) 6 Asbestos-Cement 9 Other (specify below) Welded
XX PVC 4 ABS 7 Fiberglass Threaded
Blank casing diameter ... 4. 1/2 ... in. to ... 120 ... ft., Dia ... 4. 1/2 ... in. to ... 140-160 ... ft., Dia ... in. to ... ft.
Casing height above land surface ... 24 ... in., weight ... 2.7 ... lbs./ft. Wall thickness or gauge No. ... 291

TYPE OF SCREEN OR PERFORATION MATERIAL: XX PVC 10 Asbestos-cement
1 Steel 3 Stainless steel 5 Fiberglass 8 RMP (SR) 11 Other (specify)
2 Brass 4 Galvanized steel 6 Concrete tile 9 ABS 12 None used (open hole)

SCREEN OR PERFORATION OPENINGS ARE: 5 Gauzed wrapped XX Saw cut 11 None (open hole)
1 Continuous slot 3 Mill slot 6 Wire wrapped 9 Drilled holes
2 Louvered shutter 4 Key punched 7 Torch cut 10 Other (specify)

SCREEN-PERFORATED INTERVALS: From ... 120 ... ft. to ... 140 ... ft., From ... ft. to ... ft.
GRAVEL PACK INTERVALS: From ... 12 ... ft. to ... 160 ... ft., From ... ft. to ... ft.

6 GROUT MATERIAL: XX Neat cement 2 Cement grout 3 Bentonite 4 Other
Grout Intervals: From ... 0 ... ft. to ... 12 ... ft., From ... ft. to ... ft., From ... ft. to ... ft.
What is the nearest source of possible contamination: 10 Livestock pens 14 Abandoned water well
1 Septic tank 4 Lateral lines 7 Pit privy 11 Fuel storage 15 Oil well/Gas well
2 Sewer lines 5 Cess pool 8 Sewage lagoon 12 Fertilizer storage 16 Other (specify below)
3 Watertight sewer lines 6 Seepage pit XX Feedyard 13 Insecticide storage
Direction from well? East How many feet? 50

FROM	TO	LITHOLOGIC LOG	FROM	TO	LITHOLOGIC LOG
0	5	Topsoil			
5	60	Med. to Fine Sand, Strippy Clay			
60	83	Clay			
83	135	Fine to Med. Sand			
135	145	Clay			
145	160	Fine Sand and Medium Sand			

7 CONTRACTOR'S OR LANDOWNER'S CERTIFICATION: This water well was (1) constructed, (2) reconstructed, or (3) plugged under my jurisdiction and was completed on (mo/day/year) Feb. 11, 1987 and this record is true to the best of my knowledge and belief. Kansas Water Well Contractor's License No. 252 This Water Well Record was completed on (mo/day/yr) Feb. 19, 1987 under the business name of FRIESEN WINDMILL & SUPPLY INC. by (signature)

INSTRUCTIONS: Use typewriter or ball point pen. PLEASE PRESS FIRMLY and PRINT clearly. Please fill in blanks, underline or circle the correct answers. Send top three copies to Kansas Department of Health and Environment, Office of Oil Field and Environmental Geology, Regulation and Permitting Section, Topeka, Kansas 66620-7500, Telephone: 913-862-9360. Send one to WATER WELL OWNER and retain one for your records.

PREPAID

OFFICE USE ONLY
T
R
EW
SEC.