


1 LOCATION OF WATER WELL: Fraction SW 1/4 NW 1/4 SE 1/4 Section Number 32 Township Number T 31 S Range Number R 18 E10
 County: Comanche
 Distance and direction from nearest town or city street address of well if located within city?

2 WATER WELL OWNER: Roy Boisseau
 RR#, St. Address, Box #: HCR 64 Board of Agriculture, Division of Water Resources
 City, State, ZIP Code: Coldwater Ks 67029 Application Number:

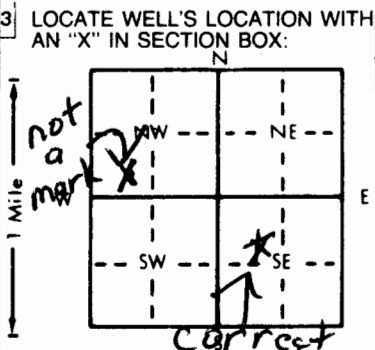

4 DEPTH OF COMPLETED WELL 120 ft. ELEVATION:
 Depth(s) Groundwater Encountered 1. 89 ft. 2. _____ ft. 3. _____ ft.
 WELL'S STATIC WATER LEVEL 85 ft. below land surface measured on mo/day/yr 10-22-94
 Pump test data: Well water was 85 ft. after .5 hours pumping 15 gpm
 Est. Yield 15+ gpm: Well water was _____ ft. after _____ hours pumping _____ gpm
 Bore Hole Diameter 9 in. to 120 ft. and _____ in. to _____ ft.
 WELL WATER TO BE USED AS:
 5 Public water supply 8 Air conditioning 11 Injection well
 1 Domestic 3 Feedlot 6 Oil field water supply 9 Dewatering 12 Other (Specify below)
 2 Irrigation 4 Industrial 7 Lawn and garden only 10 Monitoring well livestock (windmill)
 Was a chemical/bacteriological sample submitted to Department? Yes NO If yes, mo/day/yr sample was submitted
 Water Well Disinfected? Yes No

5 TYPE OF BLANK CASING USED:
 1 Steel 3 RMP (SR) 5 Wrought iron 8 Concrete tile CASING JOINTS: Glued _____ Clamped _____
2 PVC 4 ABS 6 Asbestos-Cement 9 Other (specify below) Welded _____
 7 Fiberglass Threaded _____
 Blank casing diameter 5 in. to 80 ft. Dia _____ in. to _____ ft. Dia _____ in. to _____ ft.
 Casing height above land surface 20 in. weight 2.87 lbs./ft. Wall thickness or gauge No. .265 SOR 21
 TYPE OF SCREEN OR PERFORATION MATERIAL:
 1 Steel 3 Stainless steel 5 Fiberglass 7 PVC 10 Asbestos-cement
 2 Brass 4 Galvanized steel 6 Concrete tile 8 RMP (SR) 11 Other (specify) _____
 9 ABS 12 None used (open hole)
 SCREEN OR PERFORATION OPENINGS ARE:
 1 Continuous slot 3 Mill slot 5 Gauzed wrapped 8 Saw cut 11 None (open hole)
 2 Louvered shutter 4 Key punched 6 Wire wrapped 9 Drilled holes
 7 Torch cut 10 Other (specify) _____
 SCREEN-PERFORATED INTERVALS: From 80 ft. to 110 ft. From _____ ft. to _____ ft.
 From _____ ft. to _____ ft. From _____ ft. to _____ ft.
 GRAVEL PACK INTERVALS: From 110 ft. to 70 ft. From _____ ft. to _____ ft.
 From _____ ft. to _____ ft. From _____ ft. to _____ ft.

6 GROUT MATERIAL: 1 Neat cement 2 Cement grout 3 Bentonite 4 Other _____
 Grout intervals: From 70 ft. to 60 ft. From 20 ft. to 0 ft. From _____ ft. to _____ ft.
 What is the nearest source of possible contamination:
 1 Septic tank 4 Lateral lines 7 Pit privy 10 Livestock pens 14 Abandoned water well
 2 Sewer lines 5 Cess pool 8 Sewage lagoon 11 Fuel storage 15 Oil well/Gas well
 3 Watertight sewer lines 6 Seepage pit 9 Feedyard 12 Fertilizer storage 16 Other (specify below)
 13 Insecticide storage
 Direction from well? NE How many feet? 30

| FROM | TO | LITHOLOGIC LOG | FROM | TO | PLUGGING INTERVALS |
|------|-----|---------------------------------|------|----|--------------------|
| 0 | 3 | Soil Sand | | | |
| 3 | 4 | Caliche | | | |
| 4 | 35 | Sand - fine | | | |
| 35 | 50 | Sand - gray clay | | | |
| 50 | 89 | Sand ranges from fine to medium | | | |
| 89 | 102 | gravel - coarse | | | |
| 102 | 114 | sand + gravel - medium | | | |
| 114 | 120 | sand - fine | | | |

7 CONTRACTOR'S OR LANDOWNER'S CERTIFICATION: This water well was (1) constructed, (2) reconstructed, or (3) plugged under my jurisdiction and was completed on (mo/day/year) 10-22-94 and this record is true to the best of my knowledge and belief. Kansas
 Water Well Contractor's License No. 572 This Water Well Record was completed on (mo/day/yr) 10-24-94
 under the business name of Ashland Well Service by (signature) Dee Ann

INSTRUCTIONS: Use typewriter or ball point pen. PLEASE PRESS FIRMLY and PRINT clearly. Please fill in blanks, underline or circle the correct answers. Send top three copies to Kansas Department of Health and Environment, Bureau of Water, Topeka, Kansas 66620-0001. Telephone: 913-296-5545. Send one to WATER WELL OWNER and retain one for your records.

OFFICE USE ONLY