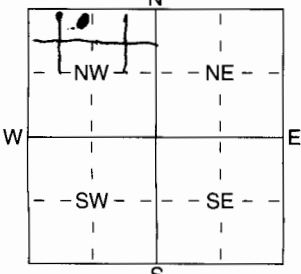


1 LOCATION OF WATER WELL: County: Comanche Fraction: NE 1/4 NW 1/4 NW 1/4 Section Number: 32 Township Number: T 31 S Range Number: R 19 E/W

Distance and direction from nearest town or city street address of well if located within city?  
3 N 5 W Coldwater

2 WATER WELL OWNER: Darrol Miller RR#, St. Address, Box #: 310 E. Maple City, State, ZIP Code: Coldwater, KS 67029 Board of Agriculture, Division of Water Resources Application Number:

3 LOCATE WELL'S LOCATION WITH AN "X" IN SECTION BOX:  4 DEPTH OF COMPLETED WELL: 106.5 ft. ELEVATION: 107 ft.

Depth(s) Groundwater Encountered: 1 ft. 2 ..... ft. 3 ..... ft.  
 WELL'S STATIC WATER LEVEL: 106.5 ft. below land surface measured on mo/day/yr 7-28-05  
 Pump test data: Well water was ..... ft. after ..... hours pumping ..... gpm  
 Est. Yield: 20 gpm: Well water was ..... ft. after ..... hours pumping ..... gpm  
 WELL WATER TO BE USED AS: 5 Public water supply 8 Air conditioning 11 Injection well  
 1 Domestic 3 Feedlot 6 Oil field water supply 9 Dewatering 12 Other (Specify below)  
 2 Irrigation 4 Industrial 7 Domestic (lawn & garden) 10 Monitoring well

Was a chemical/bacteriological sample submitted to Department? Yes ..... No X; If yes, mo/day/yr sample was submitted  
 Water Well Disinfected? Yes X No

5 TYPE OF BLANK CASING USED: 1 Steel 3 RMP (SR) 5 Wrought iron 8 Concrete tile CASING JOINTS: Glued X Clamped .....  
 2 PVC 4 ABS 6 Asbestos-Cement 9 Other (specify below) Welded .....  
 7 Fiberglass Threaded .....

Blank casing diameter: 5 in. to 156 ft., Dia ..... in. to ..... ft., Dia ..... in. to ..... ft.  
 Casing height above land surface: 24 in., weight 160 lbs./ft. Wall thickness or gauge No. ....

TYPE OF SCREEN OR PERFORATION MATERIAL: 1 Steel 3 Stainless Steel 5 Fiberglass 8 RMP (SR) 10 Asbestos-Cement  
 2 Brass 4 Galvanized Steel 6 Concrete tile 9 ABS 11 Other (Specify) .....  
 12 None used (open hole)

SCREEN OR PERFORATION OPENINGS ARE: 1 Continuous slot 3 Mill slot 5 Gauzed wrapped 8 Saw cut 11 None (open hole)  
 2 Louvered shutter 4 Key punched 6 Wire wrapped 9 Drilled holes  
 7 Torch cut 10 Other (specify) .....

SCREEN-PERFORATED INTERVALS: From 156 ft. to 164 ft., From ..... ft. to ..... ft.  
 GRAVEL PACK INTERVALS: From 20 ft. to 60 ft., From 64 ft. to 164 ft.

6 GROUT MATERIAL: 1 Neat cement 2 Cement grout 3 Bentonite 4 Other .....

Grout intervals: From 3 ft. to 20 ft., From 60 ft. to 64 ft., From ..... ft. to ..... ft.

What is the nearest source of possible contamination: 1 Septic tank 4 Lateral lines 7 Pit privy 10 Livestock pens 14 Abandoned water well  
 2 Sewer lines 5 Cess pool 8 Sewage lagoon 11 Fuel storage 15 Oil well/Gas well  
 3 Watertight sewer lines 6 Seepage pit 9 Feedyard 12 Fertilizer storage 16 Other (specify below)  
 13 Insecticide storage Irrigation Well

Direction from well? East How many feet? 1000'

FROM	TO	LITHOLOGIC LOG	FROM	TO	PLUGGING INTERVALS
0	2	soil			
2	50	Clean Sand			
50	66	White Clay			
66	80	Brown Clay			
80	95	Fine Sand			
95	102	Brown Clay			
102	112	Fine sand			
112	120	wht Clay			
120	142	Fine Sand w/Clay streaks			
142	152	fine sand			
152	164	Sand			

7 CONTRACTOR'S OR LANDOWNER'S CERTIFICATION: This water well was (1) constructed, (2) reconstructed, or (3) plugged under my jurisdiction and was completed on (mo/day/year) 7-28-05 and this record is true to the best of my knowledge and belief. Kansas Water Well Contractor's Licence No. 140 This Water Well Record was completed on (mo/day/yr) 7-31-05 under the business name of Lynan's Inc by (signature) Douglas L. Lynan