


1 LOCATION OF WATER WELL: Fraction SE 1/4 SW 1/4 NE 1/4 Section Number 9 Township Number T 31 S Range Number R 20 EW

Distance and direction from nearest town or city street address of well if located within city? 16-17 Miles S. of Bucklin to Protection Sign.  
East to where blacktop curves South. Turn North, go 5 Miles to Huck Ranch Sign

2 WATER WELL OWNER: Huck Ranch  
RR#, St. Address, Box #: HC 65, Box 43 Board of Agriculture, Division of Water Resources  
City, State, ZIP Code: Coldwater, KS 67029 Application Number:

3 LOCATE WELL'S LOCATION WITH AN "X" IN SECTION BOX:

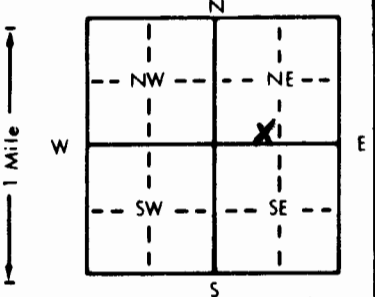

4 DEPTH OF COMPLETED WELL: 100' ft. ELEVATION:  
Depth(s) Groundwater Encountered 1. . . . . ft. 2. . . . . ft. 3. . . . . ft.  
WELL'S STATIC WATER LEVEL: 22' . . . . . ft. below land surface measured on mo/day/yr 05/21/90  
Pump test data: Well water was . . . . . ft. after . . . . . hours pumping . . . . . gpm  
Est. Yield . . . . . gpm: Well water was . . . . . ft. after . . . . . hours pumping . . . . . gpm  
Bore Hole Diameter: 36" . . . . . in. to 100' . . . . . ft., and . . . . . in. to . . . . . ft.  
WELL WATER TO BE USED AS: 5 Public water supply 8 Air conditioning 11 Injection well  
1 Domestic 3 Feedlot 6 Oil field water supply 9 Dewatering 12 Other (Specify below)  
2 Irrigation 4 Industrial 7 Lawn and garden only 10 Monitoring well . . . . .  
Was a chemical/bacteriological sample submitted to Department? Yes . . . . . No X . . . . .; If yes, mo/day/yr sample was submitted  
Water Well Disinfected? Yes X No

5 TYPE OF BLANK CASING USED: 1 Steel 2 PVC 3 RMP (SR) 4 ABS 5 Wrought iron 6 Asbestos-Cement 7 Fiberglass 8 Concrete tile 9 Other (specify below) CASING JOINTS: Glued . . . . . Clamped . . . . . Welded X . . . . . Threaded . . . . .  
Blank casing diameter: 16" . . . . . in. to 100' 60" . . . . . ft., Dia . . . . . in. to . . . . . ft., Dia . . . . . in. to . . . . . ft.  
Casing height above land surface: 3' . . . . . in., weight . . . . . lbs./ft. Wall thickness or gauge No. . . . .  
TYPE OF SCREEN OR PERFORATION MATERIAL: 1 Steel 2 Brass 3 Stainless steel 4 Galvanized steel 5 Fiberglass 6 Concrete tile 7 PVC 8 RMP (SR) 9 ABS 10 Asbestos-cement 11 Other (specify) 12 None used (open hole)  
SCREEN OR PERFORATION OPENINGS ARE: 1 Continuous slot 2 Louvered shutter 3 Mill slot 4 Key punched 5 Gauzed wrapped 6 Wire wrapped 7 Torch cut 8 Saw cut 9 Drilled holes 10 Other (specify) 11 None (open hole)  
SCREEN-PERFORATED INTERVALS: From 60' . . . . . ft. to 100' . . . . . ft., From . . . . . ft. to . . . . . ft., From . . . . . ft. to . . . . . ft.  
GRAVEL PACK INTERVALS: From 20' . . . . . ft. to 100' . . . . . ft., From . . . . . ft. to . . . . . ft., From . . . . . ft. to . . . . . ft.

6 GROUT MATERIAL: 1 Neat cement 2 Cement grout 3 Bentonite 4 Other  
Grout intervals: From 1' . . . . . ft. to 20' . . . . . ft., From . . . . . ft. to . . . . . ft., From . . . . . ft. to . . . . . ft.  
What is the nearest source of possible contamination: 1 Septic tank 2 Sewer lines 3 Watertight sewer lines 4 Lateral lines 5 Cess pool 6 Seepage pit 7 Pit privy 8 Sewage lagoon 9 Feedyard 10 Livestock pens 11 Fuel storage 12 Fertilizer storage 13 Insecticide storage 14 Abandoned water well 15 Oil well/Gas well 16 Other (specify below)  
Direction from well? West How many feet? 60'

FROM	TO	LITHOLOGIC LOG	FROM	TO	PLUGGING INTERVALS
0'	2'	Top Soil			
2'	12'	Silty Sand			
12'	42'	Silty Clay with Gravel, Mixed			
42'	56'	Coarse Sand, Large to Very Large Gravel, Extra Loose			
56'	63'	Black Silty Clay, Very Loose			
63'	87'	Coarse Sand, Large to Very Large Gravel, Extra Loose			
87'	91'	Tan, White, and Yellow Clay, Firm Drilling			
91'	100'	Very Firm Red Bed			
	100'	Total Depth			

7 CONTRACTOR'S OR LANDOWNER'S CERTIFICATION: This water well was (1) constructed (2) reconstructed, or (3) plugged under my jurisdiction and was completed on (mo/day/year) . . . . . May 21, 1990 . . . . . and this record is true to the best of my knowledge and belief. Kansas Water Well Contractor's License No. . . . . 514 . . . . . This Water Well Record was completed on (mo/day/yr) . . . . . 06/06/90 . . . . . under the business name of Miller Gearhead & Pump Repair, Inc. by (signature) Everett Miller

OFFICE USE ONLY  
T  
R  
EW  
SEC.  
1/4  
1/4  
1/4