


1 LOCATION OF WATER WELL: Fraction **W1/2 1/4 W1/2 1/4 NE 1/4** Section Number **25** Township Number **T 31 S** Range Number **R 22 E/W**  
 County: **Clark**

Distance and direction from nearest town or city street address of well if located within city? **From the jct. of #34 & #160 E. of Ashland 7.5N., to Bluff Creek Bridge, 1st Rd. N of bridge 1.3W., to Feed lot W drive N., to lease Rd. W into**

2 WATER WELL OWNER: **Sho-Bar Energy** #1 Clark  
 RR#, St. Address, Box #: **P.O. Box 442** Board of Agriculture, Division of Water Resources  
 City, State, ZIP Code: **Laverne, Ok 73848** Application Number: **970225**

3 LOCATE WELL'S LOCATION WITH AN "X" IN SECTION BOX:

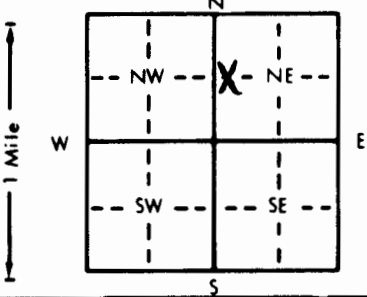

4 DEPTH OF COMPLETED WELL: **160** ft. ELEVATION: .....  
 Depth(s) Groundwater Encountered 1. .... **20** .....ft. 2. ....ft. 3. ....ft.  
 WELL'S STATIC WATER LEVEL .... **20** ..... ft. below land surface measured on mo/day/yr ... **5-7-97** .....  
 Pump test data: Well water was ... **84** ..... ft. after ... **1** ..... hours pumping ... **120** ..... gpm  
 Est. Yield ... **120** gpm: Well water was ..... ft. after ..... hours pumping ..... gpm  
 Bore Hole Diameter ... **11** ..... in. to ... **160** ..... ft., and ..... in. to ..... ft.  
 WELL WATER TO BE USED AS: 5 Public water supply 8 Air conditioning 11 Injection well  
 1 Domestic 3 Feedlot **6** Oil field water supply 9 Dewatering 12 Other (Specify below)  
 2 Irrigation 4 Industrial 7 Lawn and garden only 10 Monitoring well .....  
 Was a chemical/bacteriological sample submitted to Department? Yes.....No.....**X**.....; If yes, mo/day/yr sample was submitted  
 Water Well Disinfected? Yes **X** No

5 TYPE OF BLANK CASING USED: 5 Wrought iron 8 Concrete tile CASING JOINTS: Glued .. **X** .. Clamped .....  
 1 Steel 3 RMP (SR) 6 Asbestos-Cement 9 Other (specify below) Welded .....  
**2** PVC 4 ABS 7 Fiberglass ..... Threaded .....  
 Blank casing diameter .... **11** ..... in. to ... **160** ..... ft., Dia ..... in. to ..... ft., Dia ..... in. to ..... ft.  
 Casing height above land surface. .... **24** ..... in., weight .... **2.902** ..... lbs./ft. Wall thickness or gauge No. ... **281 SDR 21** ...

TYPE OF SCREEN OR PERFORATION MATERIAL: **7** PVC 10 Asbestos-cement  
 1 Steel 3 Stainless steel 5 Fiberglass 8 RMP (SR) 11 Other (specify) .....  
 2 Brass 4 Galvanized steel 6 Concrete tile 9 ABS 12 None used (open hole)

SCREEN OR PERFORATION OPENINGS ARE: 5 Gauzed wrapped **8** Saw cut 11 None (open hole)  
 1 Continuous slot 3 Mill slot 6 Wire wrapped 9 Drilled holes  
 2 Louvered shutter 4 Key punched 7 Torch cut 10 Other (specify) .....

SCREEN-PERFORATED INTERVALS: From .... **20** ..... ft. to ... **160** ..... ft., From ..... ft. to ..... ft.  
 From ..... ft. to ..... ft., From ..... ft. to ..... ft.  
 GRAVEL PACK INTERVALS: From .... **20** ..... ft. to ... **160** ..... ft., From ..... ft. to ..... ft.  
 From ..... ft. to ..... ft., From ..... ft. to ..... ft.

6 GROUT MATERIAL: **1** Heat cement 2 Cement grout 3 Bentonite **4** Other **Hole Plug**  
 Grout intervals: From .... **0** ..... ft. to ... **20** ..... ft., From ..... ft. to ..... ft., From ..... ft. to ..... ft.

What is the nearest source of possible contamination: 10 Livestock pens 14 Abandoned water well  
 1 Septic tank 4 Lateral lines 7 Pit privy 11 Fuel storage **15** Oil well/Gas well  
 2 Sewer lines 5 Cess pool 8 Sewage lagoon 12 Fertilizer storage 16 Other (specify below)  
 3 Watertight sewer lines 6 Seepage pit 9 Feedyard 13 Insecticide storage  
 Direction from well? **East** How many feet? **1500**

FROM	TO	LITHOLOGIC LOG	FROM	TO	PLUGGING INTERVALS
0	12	Red Clay			
12	23	Sandy Clay			
23	57	Coarse Sand			
57	63	Black Clay			
63	160	Red Sandstone			

7 CONTRACTOR'S OR LANDOWNER'S CERTIFICATION: This water well was **(1)** constructed, (2) reconstructed, or (3) plugged under my jurisdiction and was completed on (mo/day/year) ... **5-7-97** ... and this record is true to the best of my knowledge and belief. Kansas Water Well Contractor's License No. ... **KWACL - 430** ... This Water Well Record was completed on (mo/day/yr) ... **5-7-97** ... under the business name of **Howard Drlg. Box 806 Beaver, ok 73932** by signature *[Signature]*

OFFICE USE ONLY T R E/W SEC. 1/4 1/4 1/4