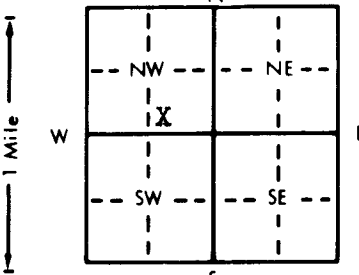


1 LOCATION OF WATER WELL: County: **Clark** Fraction: **SW 1/4 SW 1/4 NW 1/4** Section Number: **16** Township Number: **T 31 S** Range Number: **R 23 E/W**

Distance and direction from nearest town or city street address of well if located within city?
10 North, 2 3/4 West of Ashland, Kansas #3 Location

2 WATER WELL OWNER: **Mr. David Bouziden**
 RR#, St. Address, Box #: **Ashland, Kansas 67831**
 City, State, ZIP Code: **Ashland, Kansas 67831**
 Board of Agriculture, Division of Water Resources
 Application Number: **---**

3 LOCATE WELL'S LOCATION WITH AN "X" IN SECTION BOX:

 4 DEPTH OF COMPLETED WELL: **85** ft. ELEVATION: **Slope**
 Depth(s) Groundwater Encountered: 1. **Not available** 2. **Not available** 3. **Not available**
 WELL'S STATIC WATER LEVEL: **35** ft. below land surface measured on mo/day/yr **Feb. 28, 1991**
 Pump test data: Well water was _____ ft. after _____ hours pumping _____ gpm
 Est. Yield: **8** gpm: Well water was _____ ft. after _____ hours pumping _____ gpm
 Bore Hole Diameter: **10** in. to **85** ft., and _____ in. to _____ ft.
 WELL WATER TO BE USED AS:
 Domestic 3 Feedlot 6 Oil field water supply 9 Dewatering 12 Other (Specify below)
 2 Irrigation 4 Industrial 7 Lawn and garden only 10 Monitoring well
 Was a chemical/bacteriological sample submitted to Department? Yes _____ No **XX**; If yes, mo/day/yr sample was submitted
 Water Well Disinfected? Yes **XX** No

5 TYPE OF BLANK CASING USED:
 1 Steel 3 RMP (SR) 6 Asbestos-Cement 9 Other (specify below) Welded
 XX PVC 4 ABS 7 Fiberglass _____ Threaded
 Blank casing diameter: **5** in. to **65** ft., Dia _____ in. to _____ ft., Dia _____ in. to _____ ft.
 Casing height above land surface: **20** in., weight **2.8** lbs./ft. Wall thickness or gauge No. **.265**
 TYPE OF SCREEN OR PERFORATION MATERIAL:
 1 Steel 3 Stainless steel 5 Fiberglass 8 RMP (SR) 10 Asbestos-cement
 2 Brass 4 Galvanized steel 6 Concrete tile 9 ABS 12 None used (open hole)
 SCREEN OR PERFORATION OPENINGS ARE:
 1 Continuous slot 3 Mill slot 6 Wire wrapped **XX** Saw cut 11 None (open hole)
 2 Louvered shutter 4 Key punched 7 Torch cut 10 Other (specify) _____
 SCREEN-PERFORATED INTERVALS: From **65** ft. to **85** ft., From _____ ft. to _____ ft.
 From _____ ft. to _____ ft., From _____ ft. to _____ ft.
 GRAVEL PACK INTERVALS: From **20** ft. to **85** ft., From _____ ft. to _____ ft.
 From _____ ft. to _____ ft., From _____ ft. to _____ ft.

6 GROUT MATERIAL: 1 Neat cement 2 Cement grout 3 Bentonite **XX** Other **Baroid Hole Plug**
 Grout intervals: From **0** ft. to **20** ft., From _____ ft. to _____ ft., From _____ ft. to _____ ft.
 What is the nearest source of possible contamination: **None**
 1 Septic tank 4 Lateral lines 7 Pit privy 10 Livestock pens 14 Abandoned water well
 2 Sewer lines 5 Cess pool 8 Sewage lagoon 11 Fuel storage 15 Oil well/Gas well
 3 Watertight sewer lines 6 Seepage pit 9 Feedyard 12 Fertilizer storage 16 Other (specify below)
 13 Insecticide storage
 Direction from well? _____ How many feet? _____

FROM	TO	LITHOLOGIC LOG	FROM	TO	PLUGGING INTERVALS
0	2	Topsoil			
2	19	Caliche			
19	54	Mudstone			
54	75	Sandstone and Black Shale			
75	85	Black Shale			

RECEIVED
 MAY 03 1991
 DIVISION OF ENVIRONMENT

7 CONTRACTOR'S OR LANDOWNER'S CERTIFICATION: This water well was (1) constructed, (2) reconstructed, or (3) plugged under my jurisdiction and was completed on (mo/day/year) **February 28, 1991** and this record is true to the best of my knowledge and belief. Kansas Water Well Contractor's License No. **252** This Water Well Record was completed on (mo/day/year) **April 9, 1991** under the business name of **Friesen Windmill & Supply Inc.** by (signature) _____

500120250