


1 LOCATION OF WATER WELL: Fraction **NE 1/4 NE 1/4 SW 1/4** Section Number **21** Township Number **T 31 S** Range Number **R 23 E/W**
 County: **Clark**

Distance and direction from nearest town or city street address of well if located within city?
9 North, 2 3/4 West of Ashland, Kansas

2 WATER WELL OWNER: **Mr. David Bouziden #4 Location**
 RR#, St. Address, Box # : **Board of Agriculture, Division of Water Resources**
 City, State, ZIP Code : **Ashland, Kansas 67831** Application Number: **---**

3 LOCATE WELL'S LOCATION WITH AN "X" IN SECTION BOX:

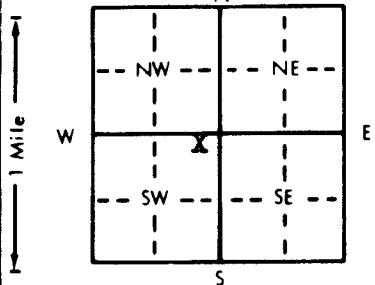

4 DEPTH OF COMPLETED WELL: **50** ft. ELEVATION: **Slope**
 Depth(s) Groundwater Encountered **1. Not available** ft. 2. ft. 3. ft.
 WELL'S STATIC WATER LEVEL **.15** ft. below land surface measured on **mo/day/yr March 19, 1991**
 Pump test data: Well water was ft. after hours pumping gpm
 Est. Yield **4** gpm: Well water was ft. after hours pumping gpm
 Bore Hole Diameter **.10** in. to **.50** ft., and in. to ft.
 WELL WATER TO BE USED AS: 5 Public water supply 8 Air conditioning 11 Injection well
 Domestic 3 Feedlot 6 Oil field water supply 9 Dewatering 12 Other (Specify below)
 2 Irrigation 4 Industrial 7 Lawn and garden only 10 Monitoring well
 Was a chemical/bacteriological sample submitted to Department? Yes. No. ; If yes, mo/day/yr sample was sub-
 mitted Water Well Disinfected? Yes No

5 TYPE OF BLANK CASING USED: 5 Wrought iron 8 Concrete tile CASING JOINTS: Glued Clamped
 1 Steel 3 RMP (SR) 6 Asbestos-Cement 9 Other (specify below) Welded
 PVC 4 ABS 7 Fiberglass Threaded
 Blank casing diameter **.5** in. to **.30** ft., Dia. in. to ft., Dia. in. to ft.
 Casing height above land surface **.20** in., weight **2.8** lbs./ft. Wall thickness or gauge No. **.265**
 TYPE OF SCREEN OR PERFORATION MATERIAL: PVC 10 Asbestos-cement
 1 Steel 3 Stainless steel 5 Fiberglass 8 RMP (SR) 11 Other (specify)
 2 Brass 4 Galvanized steel 6 Concrete tile 9 ABS 12 None used (open hole)
 SCREEN OR PERFORATION OPENINGS ARE: 5 Gauzed wrapped Saw cut 11 None (open hole)
 1 Continuous slot 3 Mill slot 6 Wire wrapped 9 Drilled holes
 2 Louvered shutter 4 Key punched 7 Torch cut 10 Other (specify)
 SCREEN-PERFORATED INTERVALS: From **.30** ft. to **.50** ft., From ft. to ft.
 From ft. to ft., From ft. to ft.
 GRAVEL PACK INTERVALS: From **.20** ft. to **.50** ft., From ft. to ft.
 From ft. to ft., From ft. to ft.

6 GROUT MATERIAL: 1 Neat cement 2 Cement grout 3 Bentonite Other **Baroid Hole Plug**
 Grout Intervals: From **.0** ft. to **.20** ft., From ft. to ft., From ft. to ft.
 What is the nearest source of possible contamination: **None - Pasture Well** 10 Livestock pens 14 Abandoned water well
 1 Septic tank 4 Lateral lines 7 Pit privy 11 Fuel storage 15 Oil well/Gas well
 2 Sewer lines 5 Cess pool 8 Sewage lagoon 12 Fertilizer storage 16 Other (specify below)
 3 Watertight sewer lines 6 Seepage pit 9 Feedyard 13 Insecticide storage
 Direction from well? How many feet?

FROM	TO	LITHOLOGIC LOG	FROM	TO	PLUGGING INTERVALS
0	2	Topsoil			
2	11	Clay			
11	16	Sandstone			
16	19	Caliche			
19	33	Clay			
33	50	Black Shale			

7 CONTRACTOR'S OR LANDOWNER'S CERTIFICATION: This water well was (1) constructed, (2) reconstructed, or (3) plugged under my jurisdiction and was completed on (mo/day/year) **April 12, 1991** and this record is true to the best of my knowledge and belief. Kansas Water Well Contractor's License No. **252** This Water Well Record was completed on (mo/day/year) **April 18, 1991** under the business name of **Friesen Windmill & Supply Inc.** by (signature)

1520971005-