


WATER WELL RECORD Form WWC-5 KSA 82a-1212

1 LOCATION OF WATER WELL: Fraction Section Number Township Number Range Number
COUNTY: CLARK NE 1/4 NE 1/4 NW 1/4 19 T 31 S R 24 W

Distance and direction from nearest town or city street address of well if located within city?
7 MILES SOUTH, 1.5 EAST OF MINNEOLA

2 WATER WELL OWNER: SPARKS, CARL Board of Agriculture, Division of Water Resources
RR#, St. Address, Box #: RT 1 BOX 18 Application Number:
City, State, ZIP code: MINNEOLA, KS 67865-

3 LOCATE WELL'S LOCATION WITH AN "X" IN SECTION BOX: 4 DEPTH OF COMPLETED WELL 100ELEVATION: 0
Depth(s) Groundwater Encountered 1. 0 ft. 2. 0 ft. 3. 0 ft.
WELL'S STATIC WATER LEVEL 75 ft. below land surface measured on mo/day/yr 10/14/05
Pump test data: Well water was 0 ft. after 0 hours pumping 0 gpm
Estimated Yield 0 gpm: Well water was 0 ft. after 0 hours pumping 0 gpm
Bore Hole Diameter 8.75 in. to 100 ft., and in. to 0 ft.
WELL WATER TO BE USED AS: DOMESTIC
Was a chemical/bacteriological sample submitted to department? No ;
If yes, mo/day/yr sample was submitted Water well disinfected? Yes

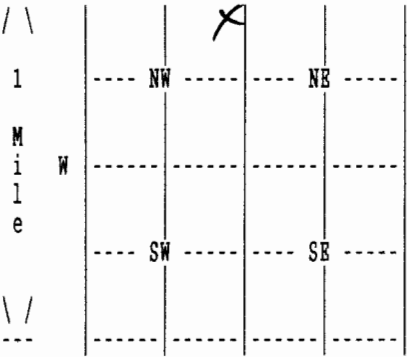

5 TYPE OF BLANK CASING USED: PVC CASING JOINTS: GLURD
Blank casing diameter 5 in. to 80 ft., Dia in. to 0 ft., Dia in. to 0 ft.
Casing height above land surface 12 in., weight 0 lbs/ft. Wall thickness or gauge No. 26
TYPE OF SCREEN OR PERFORATION MATERIAL: PVC
SCREEN OR PERFORATION OPENINGS ARE: SAW CUT

SCREEN PERFORATED INTERVALS: From 80 ft. to 100 ft., From 0 ft. to 0 ft.
From 0 ft. to 0 ft., From 0 ft. to 0 ft.
GRAVEL PACK INTERVALS: From 25 ft. to 100 ft., From 0 ft. to 0 ft.
From 0 ft. to 0 ft., From 0 ft. to 0 ft.

6 GROUT MATERIAL BENTONITE
Grout Intervals: From 4 ft. to 25 ft., From 0 ft. to 0 ft., From 0 ft. to 0 ft.
What is the nearest source of possible contamination: SEPTIC TANK
Direction from well? NORTH How many feet? 50

FROM	TO	LITHOLOGIC LOG	FROM	TO	PLUGGING INTERVALS
0	44	TAN CLAY			
44	50	SAND			
50	81	TAN CLAY			
81	84	WHITE ROCK			
84	100	SANDSTONE			

7 CONTRACTOR'S OR LANDOWNER'S CERTIFICATION: This water well was Constructed under my jurisdiction and was completed on (mo/day/year) 10/14/05 and this record is true to the best of my knowledge and belief. Kansas Water Well Contractor's License No. 653 This Water Well Record was completed on (mo/day/yr) 12/30/05 under the business name of DAN HAYSE WATER WELL SERV by (signature) Don Hayse