

USE TYPEWRITER OR BALL  
POINT PEN-PRESS FIRMLY,  
PRINT CLEARLY.

WATER WELL RECORD  
KSA 82a-1201-1215

Kansas Department of Health and  
Environment-Division of Environment  
(Water well Contractors)  
Topeka, Kansas 66620

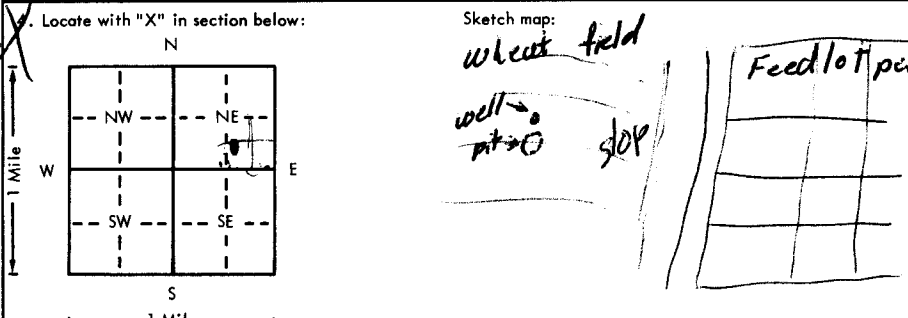
USE TYPEWRITER OR BALL  
POINT PEN-PRESS FIRMLY,  
PRINT CLEARLY.

WATER WELL RECORD  
KSA 82a-1201-1215

Kansas Department of Health and  
Environment-Division of Environment  
(Water well Contractors)  
Topeka, Kansas 66620

1. Location of well: County Clark NE 1/4 SE 1/4 SW 1/4 Section number 16 Township number 31 Range number 35 25 E

2. Distance and direction from nearest town or city: 6 S, 2 1/4 W from Minneola 3. Owner of well: Bill Thayer  
Street address of well location if in city: Minneola, Kansas  
City, state, zip code: Minneola, Kansas

4. Locate with "X" in section below: Sketch map: Wheat field Feed lot pens  


5. Type and color of material

	From	To
Top Soil	0	5
Sand rock	5	30
Gravel	30	35
Sand stone	35	75
Clay + Sand	75	100
Gravel	100	115
White Clay	115	120
Sand Rock	120	121
Shale	121	
Brock	112	
90		
22		
in g		

6. Bore hole dia. 8 1/2 in. Completion date 3-20-79  
Well depth 121 ft.

7. Cable tool Rotary Driven Dug  
Hollow rod Jetted Bored Reverse rotary

8. Use: Domestic Public supply Industry Stock  
Irrigation Air conditioning Other  
Lawn Oil field water

9. Casing: Material Surface Height: Above or below 12 in.  
Threaded Welded RMP PVC Weight 200 lbs./ft.  
Dia. 5 in. to 121 ft. depth Wall Thickness: inches or 200105  
Dia. 5 in. to 121 ft. depth gage No.

10. Screen: Manufacturer's name Jet Stream  
Type PVC Dia. 5"  
Slot/gauze 1/8" Length 20  
Set between 101 ft. and 121 ft.  
Gravel pack Yes Size range of material 1/4-1/8

11. Static water level: 90 ft. below land surface Date 3/20/79  
mo./day/yr.

12. Pumping level below land surfaces:  
90 ft. after 12 hrs. pumping 60 g.p.m.  
ft. after 12 hrs. pumping 60 g.p.m.  
Estimated maximum yield 60 g.p.m.

13. Water sample submitted: Yes No Date 3/20/79  
mo./day/yr.

14. Well head completion:  
Pitless adapter 12 inches above grade

15. Well grouted? Yes  
With: Neat cement Bentonite Concrete  
Depth: From 5 ft. to 15 ft.

16. Nearest source of possible contamination:  
ft. 1320 Direction West Type Feed lot  
Well disinfected upon completion? Yes No

17. Pump: F+W Not installed  
Manufacturer's name Flint and Walling  
Model number 50FF11 HP 5 Volts 230  
Length of drop pipe 115 ft. capacity 50 g.p.m.  
Type:  
Submersible Turbine  
Jet Reciprocating  
Centrifugal Other

18. Elevation: 19. Remarks: 2542  
112  
1430  
TOPO

20. Water well contractor's certification:  
This well was drilled under my jurisdiction and this report  
is true to the best of my knowledge and belief.  
Bertil Bely A 101  
Business name Shade No License No.  
Address Shade No  
Signed Bertil Bely Date 3/20/79  
Authorized representative

Forward the white, blue and pink copies to the Department of Health and Environment

Form WWC-5