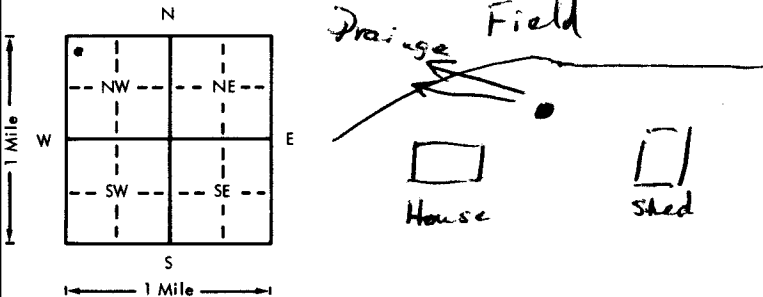


USE TYPEWRITER OR BALL
POINT PEN-PRESS FIRMLY,
PRINT CLEARLY.

WATER WELL RECORD
KSA 82a-1201-1215

Kansas Department of Health and
Environment-Division of Environment
(Water well Contractors)
Topeka, Kansas 66620

B T B B

1. Location of well:	County Clark	Fraction NW 1/4 NW 1/4 NW 1/4	Section number 3	Township number 31	Range number R - 25 - E/W
2. Distance and direction from nearest town or city: 4 mi S. Minneola Street address of well location if in city: 2 mi W. Minneola			3. Owner of well: Reid Heinman R.R. or street: R.R. City, state, zip code: Minneola, K		
4. Locate with "X" in section below: <div style="display: flex; align-items: center;"><div style="margin-right: 20px;">N 1 Mile W E S 1 Mile</div><div></div></div>			6. Bore hole dia. 8 3/4 in. Completion date 2-26-77 Well depth 110 ft.		
5. Type and color of material			7. Cable tool <input checked="" type="checkbox"/> Rotary <input type="checkbox"/> Driven <input type="checkbox"/> Dug <input type="checkbox"/> Hollow rod <input type="checkbox"/> Jetted <input type="checkbox"/> Bored <input type="checkbox"/> Reverse rotary		
			8. Use: <input checked="" type="checkbox"/> Domestic <input type="checkbox"/> Public supply <input type="checkbox"/> Industry <input type="checkbox"/> Irrigation <input type="checkbox"/> Air conditioning <input type="checkbox"/> Stock <input type="checkbox"/> Lawn <input type="checkbox"/> Oil field water <input type="checkbox"/> Other		
			9. Casing: Material PVC Height: Above or below 12 in. Threaded <input type="checkbox"/> Welded <input checked="" type="checkbox"/> Surface 12 in. RMP <input type="checkbox"/> PVC <input checked="" type="checkbox"/> Weight <input type="checkbox"/> lbs./ft. Dia. 5 in. to 110 ft. depth Wall Thickness: inches or Dia. <input type="checkbox"/> in. to <input type="checkbox"/> ft. depth Gauge No. 310		
			10. Screen: Manufacturer's name Sunflower Type Hydra Dia. 5" Slot gauge 1/16 Length 20 ft. Set between 90 ft. and 110 ft. Gravel pack? <input checked="" type="checkbox"/> Size range of material 1/16 - 1/4		
			11. Static water level: 25 ft. below land surface Date 2-26-77 12. Pumping level below land surfaces: W ft. after 80 hrs. pumping 20 g.p.m. W ft. after <input type="checkbox"/> hrs. pumping <input type="checkbox"/> g.p.m. Estimated maximum yield 35 g.p.m.		
13. Water sample submitted: <input type="checkbox"/> Yes <input checked="" type="checkbox"/> No Date <input type="checkbox"/>			14. Well head completion: <input checked="" type="checkbox"/> Pitless adapter 12 inches above grade		
15. Well grouted? <input type="checkbox"/> With: <input type="checkbox"/> Neat cement <input type="checkbox"/> Bentonite <input checked="" type="checkbox"/> Concrete Depth: From 0 ft. to 15 ft.			16. Nearest source of possible contamination: ft. 350 Direction W Type Cytl Tank Well disinfected upon completion? <input checked="" type="checkbox"/> Yes <input type="checkbox"/> No		
17. Pump: Manufacturer's name F+W Not installed Model number <input type="checkbox"/> HP 1/4 Volts 230 Length of drop pipe 94 ft. capacity 10 g.p.m. Type: <input checked="" type="checkbox"/> Submersible <input type="checkbox"/> Turbine <input type="checkbox"/> Jet <input type="checkbox"/> Reciprocating <input type="checkbox"/> Centrifugal <input type="checkbox"/> Other			20. Water well contractor's certification: This well was drilled under my jurisdiction and this report is true to the best of my knowledge and belief. Reid Heinman 101A Business name meade Ks License No. <input type="checkbox"/> Address meade Ks Signed Reid Heinman Date 2-26-77 Authorized representative		
18. Elevation: Topography: <input checked="" type="checkbox"/> Hill <input checked="" type="checkbox"/> Flat <input type="checkbox"/> Slope <input type="checkbox"/> Upland <input type="checkbox"/> Valley		19. Remarks: 7010 1551 110 1141			

Forward the white, blue and pink copies to the Department of Health and Environment

Form WWC-5