

USE TYPEWRITER OR BALL
POINT PEN-PRESS FIRMLY,
PRINT CLEARLY.

WATER WELL RECORD
KSA 82a-1201-1215

Kansas Department of Health and
Environment-Division of Environment
(Water well Contractors)
Topeka, Kansas 66620

CWW Inv. # 13088


Bacon #1 ADB

1. Location of well:	County Clark	Fraction NW 1/4 SE 1/4 NE 1/4	Section number 19	Township number 31	Range number 25
----------------------	---------------------	--------------------------------------	--------------------------	---------------------------	------------------------

2. Distance and direction from nearest town or city: **1 South, 1/2 East, 1 South 3/4 West, 1/2 South 1/8 East**
Street address of well location if in city: **435 Page Court, 220 West Douglas**
City, state, zip code: **Wichita, Kansas 67202**

4. Locate with "X" in section below:

Sketch map:

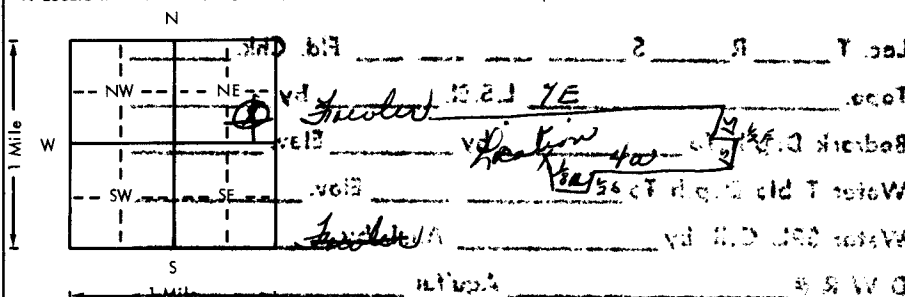

6. Bore hole dia. **9** in. Completion date **1-18-77**
Well depth **190** ft.

7. Cable tool ☒ Rotary ☐ Driven ☐ Dug
☐ Hollow rod ☐ Jetted ☐ Bored ☐ Reverse rotary

8. Use: ☐ Domestic ☐ Public supply ☐ Industry
☐ Irrigation ☐ Air conditioning ☐ Stock
☐ Lawn ☒ Oil field water ☐ Other

9. Casing: Material ☐ Height: Above or below
Threaded ☐ Welded ☐ Surface **28** in.
RMP ☐ PVC ☒ Weight **2.78** lbs./ft.
Dia. **5** in. to **100** ft. depth Wall Thickness: inches or
Dia. **5** in. to **190** ft. depth gage No. **.265**

☒ Screen: Manufacturer's name **sawed perf.**

Type **PVC** Dia. **5"**
Slot/gauze **.030** Length **80**
Set between **100** ft. and **180** ft.
Gravel pack? **yes** ft. and **1/8** to **3/16**

11. Static water level: **75** ft. below land surface Date **1-18-77**

12. Pumping level below land surfaces:
ft. after hrs. pumping g.p.m.
ft. after hrs. pumping g.p.m.
Estimated maximum yield **60** g.p.m.

13. Water sample submitted: mo./day/yr.
Yes ☒ No ☐ Date

14. Well head completion:
Pitless adapter **28** inches above grade

15. Well grouted? **yes**
With ☒ Neat cement ☐ Bentonite ☐ Concrete
Depth: From **0** ft. to **10** ft.

16. Nearest source of possible contamination:
ft. **100** Direction **NE** Type **oilwell**
Well disinfected upon completion? ☒ Yes ☐ No

17. Pump: ☒ Not installed
Manufacturer's name
Model number HP Volts
Length of drop pipe ft. capacity g.p.m.
Type:
☐ Submersible ☐ Turbine
☐ Jet ☐ Reciprocating
☐ Centrifugal ☐ Other

18. Elevation:

19. Remarks:

Topography:
☐ Hill
☐ Slope
☒ Upland
☐ Valley

20. Water well contractor's certification:
This well was drilled under my jurisdiction and this report
is true to the best of my knowledge and belief.
Carlisle Water Well 118
Business name License No.
Address **Box 275, Liberal, Ks.**
Signed **Edward S. Means** Date **1-28-77**
Authorized representative

Forward the white, blue and pink copies to the Department of Health and Environment

Form WWC-5