


1 LOCATION OF WATER WELL: County: Meade	Fraction SW 1/4      NE 1/4      SW 1/4	Section Number 6	Township Number T 31 S	Range Number R 26 EW
--	--	---------------------	---------------------------	-------------------------

Distance and direction from nearest town or city street address of well if located within city? 01928012 MW-14  
 Approximately 125 Feet North & 110 Feet West of NE Corner of Intersection of Old Highway 54 and Main Street, Fowler, KS

2 WATER WELL OWNER: Fowler Equity Exchange  
 RR#, St. Address, Box # : P.O. Box 305 Board of Agriculture, Division of Water Resources  
 City, State, ZIP Code : Fowler, KS 67844 Application Number:

3 LOCATE WELL'S LOCATION WITH AN "X" IN SECTION BOX:

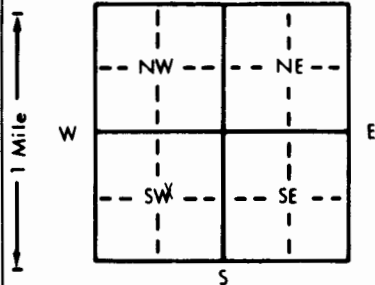

4 DEPTH OF COMPLETED WELL: 20.0 ft. ELEVATION: Approx. 2476.4 GL.  
 Depth(s) Groundwater Encountered 1. 15.0 ft. 2. ft. 3. ft.  
 WELL'S STATIC WATER LEVEL: 14.45 ft. below land surface measured on mo/day/yr 04/28/92.  
 Pump test data: Well water was ft. after hours pumping gpm  
 Est. Yield gpm: Well water was ft. after hours pumping gpm  
 Bore Hole Diameter: 4.25 in. to 20.0 ft., and in. to ft.  
 WELL WATER TO BE USED AS:  
 1 Domestic 3 Feedlot 6 Oil field water supply 9 Dewatering 12 Other (Specify below)  
 2 Irrigation 4 Industrial 7 Lawn and garden only 10 Monitoring well  
 Was a chemical/bacteriological sample submitted to Department? Yes No X; If yes, mo/day/yr sample was submitted  
 Water Well Disinfected? Yes No X

5 TYPE OF BLANK CASING USED:  
 1 Steel 3 RMP (SR) 6 Asbestos-Cement 9 Other (specify below) Welded  
 2 PVC 4 ABS 7 Fiberglass Threaded X  
 Blank casing diameter 2 in. to 10.0 ft., Dia. in. to ft., Dia. in. to ft.  
 Casing height above land surface -5 in., weight lbs./ft. Wall thickness or gauge No. Schedule 40  
 TYPE OF SCREEN OR PERFORATION MATERIAL:  
 1 Steel 3 Stainless steel 5 Fiberglass 8 RMP (SR) 10 Asbestos-cement  
 2 Brass 4 Galvanized steel 6 Concrete tile 9 ABS 12 None used (open hole)  
 SCREEN OR PERFORATION OPENINGS ARE:  
 1 Continuous slot 3 Mill slot 5 Gauzed wrapped 8 Saw cut 11 None (open hole)  
 2 Louvered shutter 4 Key punched 6 Wire wrapped 9 Drilled holes  
 7 Torch cut 10 Other (specify)  
 SCREEN-PERFORATED INTERVALS: From 10.0 ft. to 20.0 ft., From ft. to ft.  
 From ft. to ft., From ft. to ft.  
 GRAVEL PACK INTERVALS: From 8.0 ft. to 20.0 ft., From ft. to ft.  
 From ft. to ft., From ft. to ft.

6 GROUT MATERIAL: 1 Neat cement 2 Cement grout 3 Bentonite 4 Other  
 Grout Intervals: From 0 ft. to 8 ft., From 8 ft. to 20 ft., From ft. to ft.  
 What is the nearest source of possible contamination:  
 1 Septic tank 4 Lateral lines 7 Pit privy 10 Livestock pens 14 Abandoned water well  
 2 Sewer lines 5 Cess pool 8 Sewage lagoon 11 Fuel storage 15 Oil well/Gas well  
 3 Watertight sewer lines 6 Seepage pit 9 Feedyard 12 Fertilizer storage 16 Other (specify below)  
 13 Insecticide storage Removed UST  
 Direction from well? Southeast How many feet? Approx. 350 Feet

FROM	TO	LITHOLOGIC LOG	FROM	TO	PLUGGING INTERVALS
0	0.5	Gravel, Topsoil			
0.5	5.0	Lean to Fat Clay			
5.0	11.0	Lean to Fat Clay With Sand			
11.0	20.0	Sandy Lean Clay			

7 CONTRACTOR'S OR LANDOWNER'S CERTIFICATION: This water well was 1 constructed, (2) reconstructed, or (3) plugged under my jurisdiction and was completed on (mo/day/year) 04/28/92 and this record is true to the best of my knowledge and belief. Kansas Water Well Contractor's License No. 416 This Water Well Record was completed on (mo/day/yr) 05-13-92 under the business name of Terracon Consultants SC, Inc. by (signature) Steve Fisher

INSTRUCTIONS: Use typewriter or ball point pen. PLEASE PRESS FIRMLY and PRINT clearly. Please fill in blanks, underline or circle the correct answers. Send top three copies to Kansas Department of Health and Environment, Bureau of Water, Topeka, Kansas 66620-0001. Telephone: 913-296-5545. Send one to WATER WELL OWNER and retain one for your records.