


WATER WELL RECORD Form WWC-5 KSA 82a-1212

1 LOCATION OF WATER WELL: Fraction Section Number Township Number Range Number  
 COUNTY: **MEADE** NE 1/4 SE 1/4 SE 1/4 13 T 31 S R 26 W

Distance and direction from nearest town or city street address of well if located within city?  
**6 E. 1 3/4 S. OF FOWLER, KS**

2 WATER WELL OWNER: **LARRY MCBEE 412** Board of Agriculture, Division of Water Resources  
 RR#, St. Address, Box #: **316 POPULAR**  
 City, State, ZIP code: **MINNEOLA, KS 67865-** Application Number:

3 LOCATE WELL'S LOCATION WITH AN "X" IN SECTION BOX: 4 DEPTH OF COMPLETED WELL **165** ELEVATION: **0**  
 Depth(s) Groundwater Encountered 1. **84** ft. 2. **0** ft. 3. **0** ft.

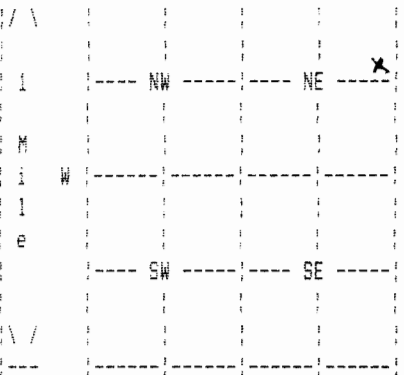

WELL'S STATIC WATER LEVEL **84** ft. below land surface measured on mo/day/yr  
 Pump test data: Well water was **0** ft. after **0** hours pumping **0** gpm  
 Estimated Yield **0** gpm: Well water was **0** ft. after **0** hours pumping **0** gpm  
 Bore Hole Diameter **8.75** in. to **165** ft., and in. to **0** ft.  
 WELL WATER TO BE USED AS: **01 DOMESTIC**  
 Was a chemical/bacteriological sample submitted to department? **No** ;  
 If yes, mo/day/yr sample was submitted Water well disinfected? **Yes**

5 TYPE OF BLANK CASING USED: **02 PVC** CASING JOINTS: **GLUED**  
 Blank casing diameter **5** in. to **145** ft., Dia in. to **0** ft., Dia in. to **0** ft.  
 Casing height above land surface **12** in., weight **0** lbs/ft. Wall thickness or gauge No. **26-21**  
 TYPE OF SCREEN OR PERFORATION MATERIAL: **07 PVC**  
 SCREEN OR PERFORATION OPENINGS ARE: **08 SAW CUT**

SCREEN PERFORATED INTERVALS: From **145** ft. to **165** ft., From **0** ft. to **0** ft.  
 From **0** ft. to **0** ft., From **0** ft. to **0** ft.  
 GRAVEL PACK INTERVALS: From **25** ft. to **165** ft., From **0** ft. to **0** ft.  
 From **0** ft. to **0** ft., From **0** ft. to **0** ft.

6 GROUT MATERIAL **03 BENTONITE**  
 Grout Intervals: From **3** ft. to **25** ft., From **0** ft. to **0** ft., From **0** ft. to **0** ft.  
 What is the nearest source of possible contamination: **CATTLE PASTURE**  
 Direction from well? **ALL** How many feet? **5**

FROM	TO	LITHOLOGIC LOG	FROM	TO	PLUGGING INTERVALS
0	6	CLAY			
6	64	TAN CLAY			
64	114	GREY CLAY			
114	165	05 SAND AND 17 GRAVEL			

7 CONTRACTOR'S OR LANDOWNER'S CERTIFICATION: This water well was Constructed under my jurisdiction and was completed on (mo/day/year) **3 / 28 / 98** and this record is true to the best of my knowledge and belief. Kansas Water Well Contractor's License No. **224** This Water Well Record was completed on (mo/day/yr) **03/31/98** under the business name of **CARL HAYSE WATER WELL SVC** by (signature) *Carl Hayse*