


WATER WELL RECORD Form WWC-5 KSA 82a-1212

1 LOCATION OF WATER WELL: Fraction Section Number Township Number Range Number  
 COUNTY: Meade SE 1/4 SE 1/4 NE 1/4 9 T 31 S R 27 W

Distance and direction from nearest town or city street address of well if located within city?  
 3 W. OF FOWLER, KANS.

2 WATER WELL OWNER: MARY C. FRAZIER #347  
 RR#. St. Address, Box #: Board of Agriculture, Division of Water Resources  
 City, State, ZIP code: FOWLER, KS 67844- Application Number:

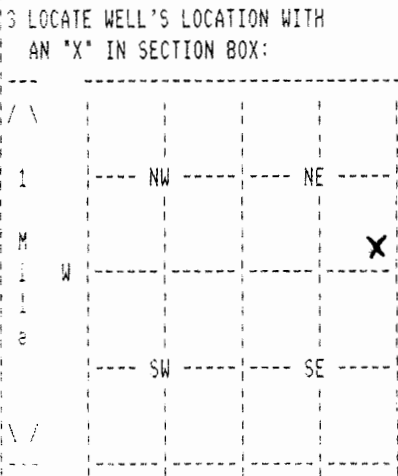

4 DEPTH OF COMPLETED WELL 180 ELEVATION: 0  
 Depth(s) Groundwater Encountered 1. 42 ft. 2. 0 ft. 3. 0 ft.  
 WELL'S STATIC WATER LEVEL 42 ft. below land surface measured on mo/day/yr  
 Pump testdata: Well water was 0 ft. after 0 hours pumping 0 gpm  
 Estimated Yield 0 gpm: Well water was 0 ft. after 0 hours pumping 0 gpm  
 Bore Hole Diameter 8.75 in. to 180 ft., and in. to 0 ft.  
 WELL WATER TO BE USED AS: 06 OIL FIELD  
 Was a chemical/bacteriological sample submitted to department? No ;  
 If yes, mo/day/yr sample was submitted Water well disinfected? Yes

5 TYPE OF BLANK CASING USED: 02 PVC CASING JOINTS: GLUED  
 Blank casing diameter 5 in. to 160 ft., Dia in. to 0 ft., Dia in. to 0 ft.  
 Casing height above land surface 12 in., weight 0 lbs/ft. Wall thickness or gauge No. 21-26  
 TYPE OF SCREEN OR PERFORATION MATERIAL: 07 PVC  
 SCREEN OR PERFORATION OPENINGS ARE: 08 SAW CUT

SCREEN PERFORATED INTERVALS: From 160 ft. to 180 ft., From 0 ft. to 0 ft.  
 From 0 ft. to 0 ft., From 0 ft. to 0 ft.  
 GRAVEL PACK INTERVALS: From 25 ft. to 180 ft., From 0 ft. to 0 ft.  
 From 0 ft. to 0 ft., From 0 ft. to 0 ft.

6 GROUT MATERIAL 03 BENTONITE  
 Grout Intervals: From 0 ft. to 25 ft., From 0 ft. to 0 ft., From 0 ft. to 0 ft.  
 What is the nearest source of possible contamination: 15 OIL/GAS WELL  
 Direction from well? SE How many feet? 65

FROM	TO	LITHOLOGIC LOG	FROM	TO	PLUGGING INTERVALS
0	35	TAN CLAY			
35	139	GREY CLAY			
139	162	05 SAND AND 17 GRAVEL			
162	164	TAN CLAY			
164	178	05 SAND AND 17 GRAVEL			
178	180	TAN CLAY			

7 CONTRACTOR'S OR LANDOWNER'S CERTIFICATION: This water well was Constructed under my jurisdiction and was completed on (mo/day/year) 2 /20/96 and this record is true to the best of my knowledge and belief. Kansas Water Well Contractor's License No. 224 This Water Well Record was completed on (mo/day/yr) 02/24/96 under the business name of CARL HAYSE WATER WELL SVC by (signature) Carl Hayse