


1 LOCATION OF WATER WELL: Fraction NW 1/4 SE 1/4 NE 1/4 Section Number 2019 Township Number T 31 S Range Number R 27 E 20

Distance and direction from nearest town or city street address of well if located within city?  
 1/4 N + 3/4 E of Meade

2 WATER WELL OWNER: Dan Hildebrand  
 RR#, St. Address, Box # :  
 City, State, ZIP Code : Fowler KS 67844  
 Board of Agriculture, Division of Water Resources  
 Application Number:

3 LOCATE WELL'S LOCATION WITH AN "X" IN SECTION BOX:

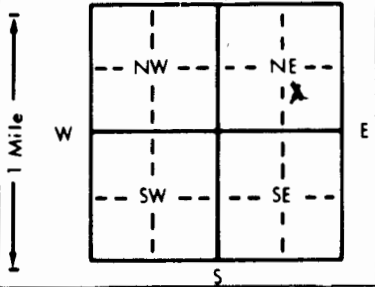

4 DEPTH OF COMPLETED WELL: 260 ft. ELEVATION:  
 Depth(s) Groundwater Encountered 1. 210 ft. 2. ft. 3. ft.  
 WELL'S STATIC WATER LEVEL 18 ft. below land surface measured on mo/day/yr 11-12-96  
 Pump test data: Well water was 80 ft. after 1 hours pumping 40 gpm  
 Est. Yield 100 gpm; Well water was ft. after hours pumping gpm  
 Bore Hole Diameter 8 3/4 in. to 260 ft. and in. to ft.  
 WELL WATER TO BE USED AS:  
 Domestic 3 Feedlot 6 Oil field water supply 9 Dewatering 12 Other (Specify below)  
 2 Irrigation 4 Industrial 7 Lawn and garden only 10 Monitoring well  
 Was a chemical/bacteriological sample submitted to Department? Yes No ; If yes, mo/day/yr sample was submitted  
 Water Well Disinfected? Yes  No

5 TYPE OF BLANK CASING USED:  
 1 Steel 3 RMP (SR) 5 Wrought iron 8 Concrete tile CASING JOINTS: Glued  Clamped  
 PVC 4 ABS 6 Asbestos-Cement 9 Other (specify below) Welded  
 7 Fiberglass Threaded  
 Blank casing diameter 5 in. to 220 ft. Dia. in. to ft. Dia. in. to ft.  
 Casing height above land surface 24 in., weight lbs./ft. Wall thickness or gauge No. 200 lbs

TYPE OF SCREEN OR PERFORATION MATERIAL:  
 PVC 10 Asbestos-cement  
 1 Steel 3 Stainless steel 5 Fiberglass 8 RMP (SR) 11 Other (specify)  
 2 Brass 4 Galvanized steel 6 Concrete tile 9 ABS 12 None used (open hole)

SCREEN OR PERFORATION OPENINGS ARE:  
 1 Continuous slot 3 Mill slot 5 Gauzed wrapped  Saw cut 11 None (open hole)  
 2 Louvered shutter 4 Key punched 6 Wire wrapped 9 Drilled holes  
 7 Torch cut 10 Other (specify)

SCREEN-PERFORATED INTERVALS: From 220 ft. to 260 ft. From ft. to ft.  
 GRAVEL PACK INTERVALS: From 20 ft. to 260 ft. From ft. to ft.

6 GROUT MATERIAL: 1 Neat cement 2 Cement grout  Bentonite 4 Other  
 Grout Intervals: From top ft. to 20 ft. From ft. to ft. From ft. to ft.

What is the nearest source of possible contamination:  
 1 Septic tank 4 Lateral lines 7 Pit privy 10 Livestock pens  Abandoned water well  
 2 Sewer lines 5 Cess pool 8 Sewage lagoon 11 Fuel storage 15 Oil well/Gas well  
 3 Watertight sewer lines 6 Seepage pit 9 Feedyard 12 Fertilizer storage 16 Other (specify below)  
 13 Insecticide storage  
 Direction from well? N How many feet? 1200

FROM	TO	LITHOLOGIC LOG	FROM	TO	PLUGGING INTERVALS
0	40	brown clay			
60	210	blue clay			
210	260	sand + gravel with streaks of clay			
		200' top - 220 Certain-top 5" SDR-21 200 PSI 73.4 PVC 1120 Well Casing 1C-ASTM F400-90 NSF-WC ASTM D 2241 NSF-PWM17C1W			220-260 5" PVC 1120 sch 80 290 PSI ASTM 1785 MPI 25-903205

7 CONTRACTOR'S OR LANDOWNER'S CERTIFICATION: This water well was  constructed, (2) reconstructed, or (3) plugged under my jurisdiction and was completed on (mo/day/year) 11-14-96 and this record is true to the best of my knowledge and belief. Kansas Water Well Contractor's License No. 101. This Water Well Record was completed on (mo/day/yr) 11-15-96 under the business name of Bartel Well Drilling, Inc. by (signature) Resler J. Bartel

OFFICE USE ONLY  
T  
R  
EW  
SEC.  
1/4  
1/4  
1/4