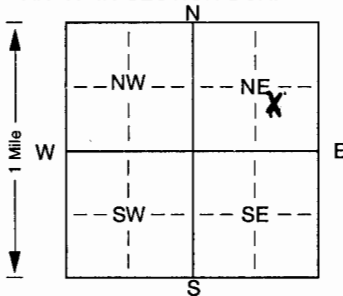


WATER WELL RECORD Form WWC-5 KSA 82a-1212 ID No.

1 LOCATION OF WATER WELL: Fraction NW 1/4 SE 1/4 NE 1/4 Section Number 26 Township Number T 31 S Range Number R 27 E (W)
 County: Meade

Distance and direction from nearest town or city street address of well if located within city?
Meade, Ks.: East on #54 to #160, 6.4 miles East to Fowler B/T, 3 mi. N., 1 mi. W., 4 mi. S., West in

2 WATER WELL OWNER: Parwest Land Expl. In
 RR#, St. Address, Box # : 2601 NW Expressway, STE 512 West
 City, State, ZIP Code : Oklahoma City, Ok 73112
 Board of Agriculture, Division of Water Resources
 Application Number: 2001 0057

3 LOCATE WELL'S LOCATION WITH AN "X" IN SECTION BOX:

 4 DEPTH OF COMPLETED WELL 210 ft. ELEVATION:
 Depth(s) Groundwater Encountered 1. 88 ft. 2. _____ ft. 3. _____ ft.
 WELL'S STATIC WATER LEVEL .88 ft. below land surface measured on mo/day/yr 3-5-01
 Pump test data: Well water was 110 ft. after 1 hours pumping .75 gpm
 Est. Yield .75 gpm: Well water was _____ ft. after _____ hours pumping _____ gpm
 Bore Hole Diameter. 12 3/4 in. to 210 ft., and _____ in. to _____ ft.
 WELL WATER TO BE USED AS: 5 Public water supply 8 Air conditioning 11 Injection well
 1 Domestic 3 Feedlot 6 Oil field water supply 9 Dewatering 12 Other (Specify below)
 2 Irrigation 4 Industrial 7 Domestic (lawn & garden) 10 Monitoring well _____
 Was a chemical/bacteriological sample submitted to Department? Yes. _____ No. X; If yes, mo/day/yr sample was submitted _____
 Water Well Disinfected? Yes X No _____

5 TYPE OF BLANK CASING USED:
 1 Steel 3 RMP (SR) 5 Wrought iron 8 Concrete tile CASING JOINTS: Glued. X Clamped. _____
 2 VVC 4 ABS 6 Asbestos-Cement 9 Other (specify below) Welded _____
 7 Fiberglass _____ Threaded _____
 Blank casing diameter .6 in. to 120 ft., Dia _____ in. to _____ ft., Dia _____ in. to _____ ft.
 Casing height above land surface .24 in., weight .4 lbs./ft. Wall thickness or gauge No. SDR 21 .316
 TYPE OF SCREEN OR PERFORATION MATERIAL:
 1 Steel 3 Stainless steel 5 Fiberglass 7 VVC 10 Asbestos-cement
 2 Brass 4 Galvanized steel 6 Concrete tile 8 RMP (SR) 11 Other (specify) _____
 9 ABS 12 None used (open hole)
 SCREEN OR PERFORATION OPENINGS ARE:
 1 Continuous slot 3 Mill slot 5 Gauzed wrapped 8 Saw cut 11 None (open hole)
 2 Louvered shutter 4 Key punched 6 Wire wrapped 9 Drilled holes
 7 Torch cut 10 Other (specify) _____ ft.
 SCREEN-PERFORATED INTERVALS: From 120 ft. to 200 ft., From _____ ft. to _____ ft.
 From _____ ft. to _____ ft., From _____ ft. to _____ ft.
 GRAVEL PACK INTERVALS: From 15 ft. to 200 ft., From _____ ft. to _____ ft.
 From _____ ft. to _____ ft., From _____ ft. to _____ ft.

6 GROUT MATERIAL: 1 Heat cement 2 Cement grout 3 Bentonite 4 Other Hole Plug
 Grout Intervals: From 1 ft. to 25 ft., From _____ ft. to _____ ft., From _____ ft. to _____ ft.
 What is the nearest source of possible contamination:
 1 Septic tank 4 Lateral lines 7 Pit privy 10 Livestock pens 14 Abandoned water well
 2 Sewer lines 5 Cess pool 8 Sewage lagoon 11 Fuel storage 15 Oil well/Gas well
 3 Watertight sewer lines 6 Seepage pit 9 Feedyard 12 Fertilizer storage 16 Other (specify below)
 13 Insecticide storage
 Direction from well? Northeast How many feet? 300

FROM	TO	LITHOLOGIC LOG	FROM	TO	PLUGGING INTERVALS
0	3	Top			
3	81	Clay			
81	88	Sand			
88	93	Sandy Clay			
93	109	Sand			
109	114	Clay			
114	143	Fine Sand/Sandy Clay Streaks			
154	158	Sandy Clay			
158	183	Sand/Few Sandy Clay Streaks			
183	210	Black/Blue Streaks			

7 CONTRACTOR'S OR LANDOWNER'S CERTIFICATION: This water well was (1) constructed, (2) reconstructed, or (3) plugged under my jurisdiction and was completed on (mo/day/year) 3-5-01 and this record is true to the best of my knowledge and belief. Kansas Water Well Contractor's Licence No. KWWCL-430 This Water Well Record was completed on (mo/day/yr) 3-5-01 under the business name of Howard Drilling Company by (signature) [Signature]

INSTRUCTIONS: Use typewriter or ball point pen. PLEASE PRESS FIRMLY and PRINT clearly. Please fill in blanks, underline or circle the correct answers. Send top three copies to Kansas Department of Health and Environment, Bureau of Water, Topeka, Kansas 66620-0001. Telephone 785-296-5524. Send one to WATER WELL OWNER and retain one for your records. Fee of \$5.00 for each constructed well.