


WATER WELL RECORD Form WWC-5 KSA 82a-1212

1 LOCATION OF WATER WELL: Fraction Section Number Township Number Range Number
 COUNTY: 060 MEADE NW 1/4 NW 1/4 NW 1/4 21 T 31 S R 27 W

Distance and direction from nearest town or city street address of well if located within city?
 FROM MEADE; APPX 3 MILES NORTH & 3 MILES EAST

2 WATER WELL OWNER: DALE ZORTMAN
 RR#, St. Address, Box # : PO BOX 476 Board of Agriculture, Division of Water Resources
 City, State, ZIP code : FOWLER, KS 67844-0476 Application Number: 17667, 42278 + 43404

3 LOCATE WELL'S LOCATION WITH AN "X" IN SECTION BOX:

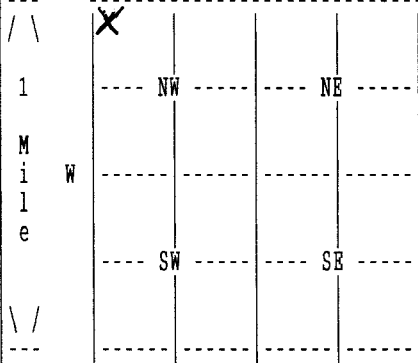

4 DEPTH OF COMPLETED WELL 360 ELEVATION: 0
 Depth(s) Groundwater Encountered 1. 0 ft. 2. 0 ft. 3. 0 ft.

WELL'S STATIC WATER LEVEL 76 ft. below land surface measured on mo/day/yr 07/08/04
 Pump test data: Well water was 198 ft. after 4 hours pumping 1100 gpm

Estimated Yield 0 gpm: Well water was 0 ft. after 0 hours pumping 0 gpm

Bore Hole Diameter 24 in. to 360 ft., and in. to 0 ft.

WELL WATER TO BE USED AS: 02 IRRIGATION

Was a chemical/bacteriological sample submitted to department? No ;
 If yes, mo/day/yr sample was submitted Water well disinfected? Yes

5 TYPE OF BLANK CASING USED: 01 STEEL CASING JOINTS: WELDED
 Blank casing diameter 16 in. to 360 ft., Dia in. to 0 ft., Dia in. to 0 ft.
 Casing height above land surface 12 in., weight 42 lbs/ft. Wall thickness or gauge No. .250
 TYPE OF SCREEN OR PERFORATION MATERIAL: 01 STEEL
 SCREEN OR PERFORATION OPENINGS ARE: 01 CONT. SLOT

SCREEN PERFORATED INTERVALS: From 190 ft. to 350 ft., From 0 ft. to 0 ft.
 From 0 ft. to 0 ft., From 0 ft. to 0 ft.
 GRAVEL PACK INTERVALS: From 20 ft. to 360 ft., From 0 ft. to 0 ft.
 From 0 ft. to 0 ft., From 0 ft. to 0 ft.

6 GROUT MATERIAL 03 BENTONITE
 Grout Intervals: From 0 ft. to 20 ft., From 0 ft. to 0 ft., From 0 ft. to 0 ft.
 What is the nearest source of possible contamination: 14 ABAND. WELL
 Direction from well? SOUTH How many feet? 20

FROM	TO	LITHOLOGIC LOG	FROM	TO	PLUGGING INTERVALS
0	1	02 SILT			
1	9	04 SANDY CLAY 31 CALICHE			
9	183	01 CLAY			
183	208	05 SAND 13 FINE GRAVEL 01 CLAY			
208	216	04 SANDY CLAY 05 SAND			
216	220	04 SANDY CLAY 05 SAND			
220	243	05 SAND 11 GRAVEL 01 CLAY			
243	268	05 SAND 13 FINE GRAVEL 01 CLAY			
268	273	04 SANDY CLAY			
273	283	07 FINE SAND 01 CLAY			

7 CONTRACTOR'S OR LANDOWNER'S CERTIFICATION: This water well was Constructed under my jurisdiction and was completed on (mo/day/year) 07/02/04 and this record is true to the best of my knowledge and belief. Kansas Water Well Contractor's License No. 145 This Water Well Record was completed on (mo/day/yr) 08/10/04 under the business name of HENKLE DRILLING & SUPPLY by (signature) -

(Continued)

WATER WELL RECORD Form WWC-5 KSA 82a-1212

1 LOCATION OF WATER WELL: COUNTY: 060 MEADE	Fraction NW 1/4 NW 1/4 NW 1/4	Section Number 21	Township Number T 31 S	Range Number R 27 W
--	----------------------------------	----------------------	---------------------------	------------------------

2 WATER WELL OWNER: DALE ZORTMAN
 RR#, St. Address, Box # : PO BOX 476
 City, State, ZIP code : FOWLER, KS 67844-0476
 Board of Agriculture, Division of Water Resources
 Application Number: 17667, 42278

FROM	TO	LITHOLOGIC LOG
283	293	04 SANDY CLAY
293	303	05 SAND 01 CLAY
303	322	07 FINE SAND
322	337	05 SAND 01 CLAY
337	342	07 FINE SAND 08 MEDIUM SAND 28 ROCK
342	350	28 ROCK 05 SAND
350	363	19 SHALE

7 CONTRACTOR'S OR LANDOWNER'S CERTIFICATION: This water well was Constructed under my jurisdiction and was completed on (mo/day/year) 07/02/04 and this record is true to the best of my knowledge and belief. Kansas Water Well Contractor's License No. 145 This Water Well Record was completed on (mo/day/yr) 08/10/04 under the business name of HENKLE DRILLING & SUPPLY by (signature) *Bruce J. Reichert*