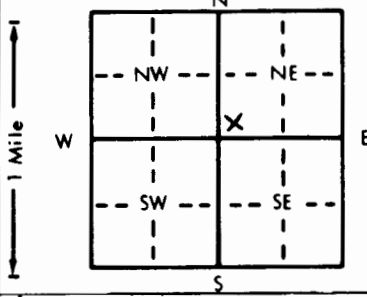


1 LOCATION OF WATER WELL: Fraction SW 1/4 SW 1/4 NE 1/4 Section Number 6 Township Number T 31 S Range Number R 27 E/W
 County: Meade

Distance and direction from nearest town or city street address of well if located within city?
From Int. of 23 & 98 N of Meade go 2 3/4 E & 1/4 S into--

2 WATER WELL OWNER: Howard Norman Board of Agriculture, Division of Water Resources
 RR#, St. Address, Box #: Box 481 Application Number:
 City, State, ZIP Code: Fowler, KS 67844

3 LOCATE WELL'S LOCATION WITH AN "X" IN SECTION BOX:


4 DEPTH OF COMPLETED WELL: 260 ft. ELEVATION:
 Depth(s) Groundwater Encountered 1. 85 ft. 2. 85 ft. 3. 85 ft.
 WELL'S STATIC WATER LEVEL 85 ft. below land surface measured on mo/day/yr 8/26/92
 Pump test data: Well water was 95 ft. after 1 hours pumping 85 gpm
 Est. Yield 85 gpm: Well water was 95 ft. after 1 hours pumping 85 gpm
 Bore Hole Diameter 9 1/2 in. to 9 1/2 in. and 9 1/2 in. to 9 1/2 in.
 WELL WATER TO BE USED AS:
 Domestic 3 Feedlot 6 Oil field water supply 9 Dewatering 12 Other (Specify below)
 2 Irrigation 4 Industrial 7 Lawn and garden only 10 Monitoring well
 Was a chemical/bacteriological sample submitted to Department? Yes no No x; If yes, mo/day/yr sample was submitted
 Water Well Disinfected? Yes x No

5 TYPE OF BLANK CASING USED:
 1 Steel 3 RMP (SR) 5 Wrought iron 8 Concrete tile CASING JOINTS: Glued x Clamped
 2 PVC 4 ABS 6 Asbestos-Cement 9 Other (specify below) Welded
 7 Fiberglass Threaded
 Casing height above land surface 24 in., weight 24 lbs./ft. Wall thickness or gauge No. 0.032
 TYPE OF SCREEN OR PERFORATION MATERIAL:
 7 PVC 10 Asbestos-cement
 1 Steel 3 Stainless steel 5 Fiberglass 8 RMP (SR) 11 Other (specify)
 2 Brass 4 Galvanized steel 6 Concrete tile 9 ABS 12 None used (open hole)
 SCREEN OR PERFORATION OPENINGS ARE:
 1 Continuous slot 3 Mill slot 5 Gauzed wrapped 8 Saw cut 11 None (open hole)
 2 Louvered shutter 4 Key punched 6 Wire wrapped 9 Drilled holes
 7 Torch cut 10 Other (specify)

6 GROUT MATERIAL: 1 Neat cement 2 Cement grout 3 Bentonite 4 Other Hole Plug
 What is the nearest source of possible contamination:
 1 Septic tank 4 Lateral lines 7 Pit privy 10 Livestock pens 14 Abandoned water well
 2 Sewer lines 5 Cess pool 8 Sewage lagoon 11 Fuel storage 15 Oil well/Gas well
 3 Watertight sewer lines 6 Seepage pit 9 Feedyard 12 Fertilizer storage 16 Other (specify below)
 13 Insecticide storage
 Direction from well? How many feet?

FROM	TO	LITHOLOGIC LOG	FROM	TO	PLUGGING INTERVALS
0	1	Surface Soil			
1	118	Clay			
118	150	Sand			
150	211	Clay			
211	227	Sand			
227	235	Clay			
235	250	Sand			
250	254	Clay			
254	260	Sand			

7 CONTRACTOR'S OR LANDOWNER'S CERTIFICATION: This water well was (1) constructed, (2) reconstructed, or (3) plugged under my jurisdiction and was completed on (mo/day/year) 8/26/92 and this record is true to the best of my knowledge and belief. Kansas Water Well Contractor's License No. KWWCL-430 This Water Well Record was completed on (mo/day/yr) 8/26/92 under the business name of Howard Drlg. Co., Box 806 BEaver, OK 73932 by (signature) Howard Drlg. Co. #14802

INSTRUCTIONS: Use typewriter or ball point pen. PLEASE PRESS FIRMLY and PRINT clearly. Please fill in blanks, underline or circle the correct answers. Send top three copies to Kansas Department of Health and Environment, Bureau of Water, Topeka, Kansas 66620-0001. Telephone: 913-296-5545. Send one to WATER WELL OWNER and retain one for your records.

#14802

OFFICE USE ONLY T R E/W SEC. 1/4 1/4 1/4