USE TYPEWRITER OR BALL POINT PEN-PRESS FIRMLY, PRINT CLEARLY.

WATER WELL RECORD
KSA 82a-1201-1215

Kansas Department of Health and Environment-Division of Environment
(Water well Contractors)
Topeka, Kansas 66620

1. Location of well:	County	Fraction	Section number	Township number	Range number
	Meade	NW 1/4 ~~SW~~ 1/4 SW 1/4	14	T 31 S	R 28 E/W

2. Distance and direction from nearest town or city: 4½ N of Meade
Street address of well location if in city:

3. Owner of well: Dale Clay
R.R. or street:
City, state, zip code: Meade Kans 67864

4. Locate with "X" in section below:

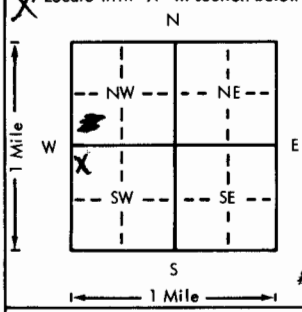

Sketch map:

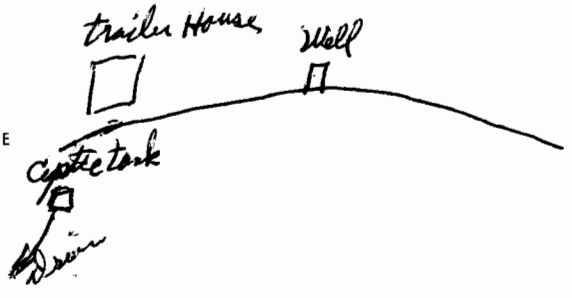

6. Bore hole dia. 8¾ in. Completion date ____
Well depth 197 ft.

7. __ Cable tool ✓ Rotary __ Driven __ Dug
__ Hollow rod __ Jetted __ Bored __ Reverse rotary

8. Use: ✓ Domestic __ Public supply __ Industry
__ Irrigation __ Air conditioning __ Stock
__ Lawn __ Oil field water __ Other

9. Casing: Material ~~Steel~~ Styrene Height: (Above) or below
Threaded ____ Welded ____ Surface 12 in.
RMP ____ PVC Blue Weight ____ lbs./ft.
Dia. 5 in. to 197 ft. depth Wall Thickness: inches or
Dia. ____ in. to ____ ft. depth gage No. 320

5. Type and color of material	From	To
Top Soil	1	4
Gray Clay	4	25
Sand	25	30
Gray Clay	30	95
Sand + Gravel	95	110
Sand	110	150
Gray Clay	151	153
Sand	153	175
Blue Clay	175	180
Sand and Gravel	180	197
(Use a second sheet if needed)		

10. Screen: Manufacturer's name Sunflower Plastic Pipe Inc
Type Styrene Dia. 5"
Slot/gauze 1/16 Length 20
Set between 177 ft. and 197 ft.
____ ft. and ____ ft.
Gravel pack? Yes Size range of material #6 - #8

11. Static water level: mo./day/yr.
77 ft. below land surface Date 7 76

12. Pumping level below land surfaces:
79 ft. after 3 hrs. pumping 20 g.p.m.
____ ft. after ____ hrs. pumping ____ g.p.m.
Estimated maximum yield 35 g.p.m.

13. Water sample submitted: mo./day/yr.
__ Yes ✓ No Date ____

14. Well head completion:
✓ Pitless adapter 12 Inches above grade

15. Well grouted? Yes
With: ✓ Neat cement ____ Bentonite ____ Concrete
Depth: From 4 ft. to 30 ft.

16. Nearest source of possible contamination:
ft. 325 Direction SW Type Cattle tank
Well disinfected upon completion? ✓ Yes ____ No

17. Pump: Not installed
Manufacturer's name Flint Walling
Model number 10BA15 HP 1 Volts 230
Length of drop pipe 120 ft. capacity 10 g.p.m.
Type:
✓ Submersible ____ Turbine
____ Jet ____ Reciprocating
____ Centrifugal ____ Other

18. Elevation:

Topography:
✓ Hill
____ Slope
____ Upland
____ Valley

19. Remarks:

20. Water well contractor's certification:
This well was drilled under my jurisdiction and this report is true to the best of my knowledge and belief.
Baxted Drlg 101A
Business name License No.
Address Meade Kans
Signed Pete P Baxted Date 6-23-76
Authorized representative

T 31 R 28 E (W) Sec 14 1/4 NW 1/4 NW 1/4 SW 1/4

Forward the white, blue and pink copies to the Department of Health and Environment

Form WWC-5

MI-1023