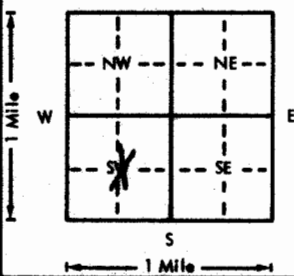
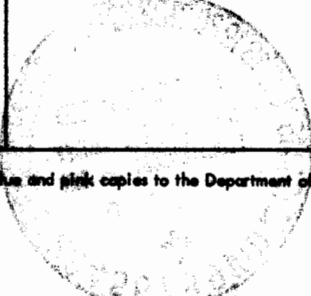


USE TYPEWRITER OR BALL
POINT PEN-PRESS FIRMLY,
PRINT CLEARLY.

WATER WELL RECORD
KSA 82a-1201-1215

Kansas Department of Health and
Environment-Division of Environment
(Water well Contractors)
Topeka, Kansas 66620

1. Location of well:	County MEADE	Fraction NW 1/4 SE 1/4 SW4	Section number 19	Township number T 31 S R	Range number 28 W
2. Distance and direction from nearest town or city: 1 Mile East, 1/4 North of Missler Elevator <small>Street address of well location if in city:</small>			3. Owner of well: Phil Berghause R.R. or street: Meade, Ks. 67864 City, state, zip code:		
4. Locate with "X" in section below: N  W E S 1 Mile			Sketch map:		
5. Type and color of material			6. Bore hole dia. 26 in. Completion date 3-11-76 Well depth 406 ft.		
			7. <input type="checkbox"/> Cable tool <input type="checkbox"/> Rotary <input type="checkbox"/> Driven <input type="checkbox"/> Dug <input type="checkbox"/> Hollow rod <input type="checkbox"/> Jetted <input type="checkbox"/> Bored <input checked="" type="checkbox"/> Reverse rotary		
			8. Use: <input type="checkbox"/> Domestic <input type="checkbox"/> Public supply <input type="checkbox"/> Industry <input checked="" type="checkbox"/> Irrigation <input type="checkbox"/> Air conditioning <input type="checkbox"/> Stock <input type="checkbox"/> Lawn <input type="checkbox"/> Oil field water <input type="checkbox"/> Other		
			9. Casing: Material Steel Height: Above or below Threaded <input type="checkbox"/> Welded <input checked="" type="checkbox"/> Surface 12 in. RMP <input type="checkbox"/> PVC <input type="checkbox"/> Weight 36.87 lbs./ft. Dia. 16 in. to 107 ft. depth; Well Thickness: inches or Dia. <input type="checkbox"/> in. to <input type="checkbox"/> ft. depth; gauge No. <input type="checkbox"/>		
			10. Screen: Manufacturer No Screen Type <input type="checkbox"/> Dia. <input type="checkbox"/> Slot/gauze <input type="checkbox"/> Length <input type="checkbox"/> Set between <input type="checkbox"/> ft. and <input type="checkbox"/> ft. Perf. 180-275 ft. and 325-406 ft. Gravel pack? <input checked="" type="checkbox"/> yes Size range of material 2" Down		
			11. Static water level: <input type="checkbox"/> mo./day/yr. 110 ft. below land surface Date 1-30-76		
			12. Pumping level below land surface: <input type="checkbox"/> ft. after <input type="checkbox"/> hrs. pumping <input type="checkbox"/> g.p.m. <input type="checkbox"/> ft. after <input type="checkbox"/> hrs. pumping <input type="checkbox"/> g.p.m. Estimated maximum yield <input type="checkbox"/> g.p.m.		
			13. Water sample submitted: <input type="checkbox"/> mo./day/yr. Yes <input type="checkbox"/> No <input type="checkbox"/> Date <input type="checkbox"/>		
			14. Well head completion: <input type="checkbox"/> Pile adapter 12 inches above grade		
			15. Well grouted? <input checked="" type="checkbox"/> yes With: <input checked="" type="checkbox"/> Neat cement <input type="checkbox"/> Bentonite <input type="checkbox"/> Concrete Depth: From 0 ft. to 10 ft.		
16. Nearest source of possible contamination: N/A ft. <input type="checkbox"/> Direction <input type="checkbox"/> Type <input type="checkbox"/> Well disinfected upon completion? <input type="checkbox"/> Yes <input checked="" type="checkbox"/> No					
17. Pump: <input type="checkbox"/> Not installed Manufacturer's name <input type="checkbox"/> Model number <input type="checkbox"/> HP <input type="checkbox"/> Volts <input type="checkbox"/> Length of drop pipe <input type="checkbox"/> ft. capacity <input type="checkbox"/> g.p.m. Type: <input type="checkbox"/> Submersible <input type="checkbox"/> Turbine <input type="checkbox"/> Jet <input type="checkbox"/> Reciprocating <input type="checkbox"/> Centrifugal <input type="checkbox"/> Other					
(Use a second sheet if needed)					
18. Elevation: Topography: <input type="checkbox"/> Hill <input checked="" type="checkbox"/> Slope <input type="checkbox"/> Upland <input type="checkbox"/> Valley	19. Remarks: Set Customer's Used Pump in new well 		20. Water well contractor's certification: This well was drilled under my jurisdiction and this report is true to the best of my knowledge and belief. Minter Wilson Drilling 208 Business name <input type="checkbox"/> License No. <input type="checkbox"/> Address P.O. Box A Garden City Ks Minter Wilson 3-30-76 Signed <input type="checkbox"/> Authorized representative Date <input type="checkbox"/>		

31 28 19
 Sec
 1/4 1/4 1/4
 NW 1/4 SE 1/4 SW 1/4

Forward the white, blue and pink copies to the Department of Health and Environment

Form WWC-5

Phone 276-8269 • P.O. Box 493 • GARDEN CITY, KANSAS 67846

PHIL BERGHAUS
MEADE COUNTY
1-30-76

Location SW 19-31-28
From Phil Berghaus House, 3/4 Mile North or
1 Mile East, 1 1/2 Mile North Of ~~Miller Elevator~~
Missler

Static Water Level 140

Test #1

0-3	Top Soil
3-27	Brown Sandy Clay
27-60	Brown & White Sandy Clay
60-102	Brown Sandy Clay
102-123	Brown Clay
123-170	Fine To Med. Sand & Gravel (Loose)
170-181	Brown Sandy Clay
181-248	Fine To Med. Sandy & Gravel (loose)
248-262	Fine To Med. Sand & Gravel, Streaks Of Clay(10%)
262-270	Fine Sand, Streak Of Clay (10%)
270-275	Fine To Med. Sand & Gravel (Loose)
275-328	Blue Clay
328-368	Fine To Med. Sand & Gravel (Loose)
368-406	Fine To Med. Sand & Gravel, Streaks of Clay (10%)
406-410	Brown, Gray, Yellow, White Clay, Small Streak Of White Rock
410-415	Gray Clay (Hard)