


1 LOCATION OF WATER WELL: County: **MEADE** Fraction: **SE 1/4 NE 1/4 NW 1/4** Section Number: **22** Township Number: **T 31 S** Range Number: **R 28 E/W**

Distance and direction from nearest town or city street address of well if located within city?  
**3 North and 1/2 West of Meade, Kansas**

2 WATER WELL OWNER: **Mr. Orville Barragree**  
 RR#, St. Address, Box #: **RFD** Board of Agriculture, Division of Water Resources  
 City, State, ZIP Code: **Meade, Kansas 67864** Application Number: **----**

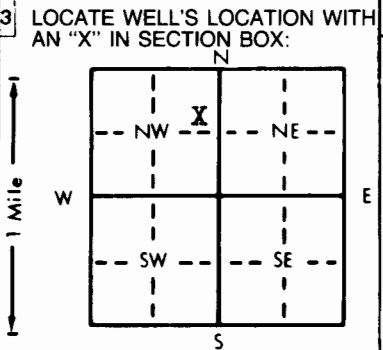

4 DEPTH OF COMPLETED WELL: **126** ft. ELEVATION: **Valley**  
 Depth(s) Groundwater Encountered: 1. **Not available** ft. 2. .... ft. 3. .... ft.  
 WELL'S STATIC WATER LEVEL: **51** ft. below land surface measured on mo/day/yr **March 22, 1984**  
 Pump test data: Well water was .... ft. after .... hours pumping .... gpm  
 Est. Yield: **100+** gpm: Well water was .... ft. after .... hours pumping .... gpm  
 Bore Hole Diameter: **9 7/8** in. to **126** in. to .... in. to .... ft.  
 WELL WATER TO BE USED AS:  
 5 Public water supply 8 Air conditioning 11 Injection well  
 Domestic 3 Feedlot 6 Oil field water supply 9 Dewatering  Other (Specify below)  
 2 Irrigation 4 Industrial 7 Lawn and garden only 10 Observation well **Stock**  
 Was a chemical/bacteriological sample submitted to Department? Yes.....No...  ...; If yes, mo/day/yr sample was submitted  
 Water Well Disinfected? Yes  No

5 TYPE OF BLANK CASING USED:  
 1 Steel 3 RMP (SR) 5 Wrought iron 8 Concrete tile CASING JOINTS: Glued...  Clamped...  
 PVC 4 ABS 7 Fiberglass 9 Other (specify below) Welded...  
 Blank casing diameter: **5** in. to **86** ft., Dia. .... in. to .... ft., Dia. .... in. to .... ft.  
 Casing height above land surface: **24** in., weight **2.8** lbs./ft. Wall thickness or gauge No. **265**  
 TYPE OF SCREEN OR PERFORATION MATERIAL:  PVC 10 Asbestos-cement  
 1 Steel 3 Stainless steel 5 Fiberglass 8 RMP (SR) 11 Other (specify) ...  
 2 Brass 4 Galvanized steel 6 Concrete tile 9 ABS 12 None used (open hole)  
 SCREEN OR PERFORATION OPENINGS ARE:  
 1 Continuous slot 3 Mill slot 5 Gauzed wrapped  Saw cut 11 None (open hole)  
 2 Louvered shutter 4 Key punched 6 Wire wrapped 9 Drilled holes  
 7 Torch cut 10 Other (specify) ...  
 SCREEN-PERFORATED INTERVALS: From **86** ft. to **126** ft., From .... ft. to .... ft.  
 GRAVEL PACK INTERVALS: From **10** ft. to **126** ft., From .... ft. to .... ft.

6 GROUT MATERIAL:  Neat cement 2 Cement grout 3 Bentonite 4 Other  
 Grout Intervals: From **0** ft. to **10** ft., From .... ft. to .... ft., From .... ft. to .... ft.  
 What is the nearest source of possible contamination:  
 1 Septic tank 4 Lateral lines 7 Pit privy 10 Livestock pens 14 Abandoned water well  
 2 Sewer lines 5 Cess pool 8 Sewage lagoon 11 Fuel storage 15 Oil well/Gas well  
 3 Watertight sewer lines 6 Seepage pit 9 Feedyard 12 Fertilizer storage  6 Other (specify below)  
**Creek**  
 Direction from well? **West** How many feet? **30**

FROM	TO	LITHOLOGIC LOG	FROM	TO	LITHOLOGIC LOG
0	5	Topsoil			
5	11	Fine Sand			
11	75	Clay			
75	128	Med. to Lar. Sand, Gravel w/Clay Streaks			

7 CONTRACTOR'S OR LANDOWNER'S CERTIFICATION: This water well was (1) constructed, (2) reconstructed, or (3) plugged under my jurisdiction and was completed on (mo/day/year) **March 29, 1984** and this record is true to the best of my knowledge and belief. Kansas Water Well Contractor's License No. **252** This Water Well Record was completed on (mo/day/yr) **April 2, 1984** under the business name of **Friesen Windmill & Supply Inc.** by (signature) *[Signature]*

INSTRUCTIONS: Use typewriter or ball point pen, PLEASE PRESS FIRMLY and PRINT clearly. Please fill in blanks, underline or circle the correct answers. Send top three copies to Kansas Department of Health and Environment, Division of Environment, Environmental Geology Section, Topeka, KS 66620. Send one to WATER WELL OWNER and retain one for your records.

OFFICE USE ONLY T 31 R 28 E/W SEC. 22 SE 1/4 NE 1/4 NW 1/4