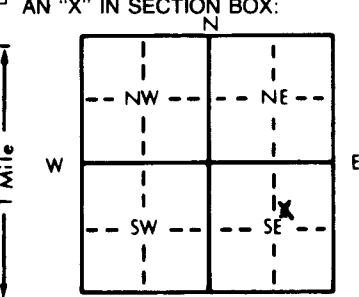


1 LOCATION OF WATER WELL: County: **MEADE** Fraction: **SW 1/4 NE 1/4 SE 1/4** Section Number: **27** Township Number: **T 31 S** Range Number: **R 28 W**

Distance and direction from nearest town or city street address of well if located within city?
500 W & 100 S of SE property corner **MW-4**

2 WATER WELL OWNER: **MEADE Co. Landfill**
 RR#, St. Address, Box # : _____
 City, State, ZIP Code : **MEADE, KS** Board of Agriculture, Division of Water Resources
 Application Number: _____


3 LOCATE WELL'S LOCATION WITH AN "X" IN SECTION BOX:

 4 DEPTH OF COMPLETED WELL: **110** ft. ELEVATION: **2559.41 MSL**
 Depth(s) Groundwater Encountered 1 **85** ft. 2 _____ ft. 3 _____ ft.
 WELL'S STATIC WATER LEVEL **85** ft. below land surface measured on mo/day/yr
 Pump test data: Well water was _____ ft. after _____ hours pumping _____ gpm
 Est. Yield _____ gpm Well water was _____ ft. after _____ hours pumping _____ gpm
 Bore Hole Diameter **9** in. to **110** ft., and _____ in. to _____ ft.
 WELL WATER TO BE USED AS:
 5 Public water supply 8 Air conditioning 11 Injection well
 1 Domestic 3 Feedlot 6 Oil field water supply 9 Dewatering 12 Other (Specify below)
 2 Irrigation 4 Industrial 7 Lawn and garden only **10** Monitoring well
 Was a chemical/bacteriological sample submitted to Department? Yes _____ No **X**; If yes, mo/day/yr sample was submitted _____
 Water Well Disinfected? Yes _____ No **X**

5 TYPE OF BLANK CASING USED:
 1 Steel 3 RMP (SR) 5 Wrought iron 8 Concrete tile CASING JOINTS: Glued _____ Clamped _____
2 PVC 4 ABS 6 Asbestos-Cement 9 Other (specify below) Welded _____
 7 Fiberglass Threaded **X**
 Blank casing diameter **4** in. to **90** ft. Dia _____ in. to _____ ft. Dia _____ in. to _____ ft.
 Casing height above land surface **36** in., weight **2.03** lbs./ft. Wall thickness or gauge No. **.237**
 TYPE OF SCREEN OR PERFORATION MATERIAL:
 1 Steel 3 Stainless steel 5 Fiberglass 8 RMP (SR) 10 Asbestos-cement
 2 Brass 4 Galvanized steel 6 Concrete tile 9 ABS 11 Other (specify) _____
 12 None used (open hole)
 SCREEN OR PERFORATION OPENINGS ARE:
 1 Continuous slot **3** Mill slot 5 Gauzed wrapped 8 Saw cut 11 None (open hole)
 2 Louvered shutter 4 Key punched 6 Wire wrapped 9 Drilled holes
 7 Torch cut 10 Other (specify) _____
 SCREEN-PERFORATED INTERVALS: From **90** ft. to **110** ft., From _____ ft. to _____ ft.
 From _____ ft. to _____ ft., From _____ ft. to _____ ft.
 GRAVEL PACK INTERVALS: From **88** ft. to **110** ft., From _____ ft. to _____ ft.
 From _____ ft. to _____ ft., From _____ ft. to _____ ft.

6 GROUT MATERIAL: **1** Neat cement **2** Cement grout **3** Bentonite 4 Other _____
 Grout intervals: From **0** ft. to **86** ft., From **86** ft. to **88** ft., From _____ ft. to _____ ft.
 What is the nearest source of possible contamination:
 1 Septic tank 4 Lateral lines 7 Pit privy 10 Livestock pens 14 Abandoned water well
 2 Sewer lines 5 Cess pool 8 Sewage lagoon 11 Fuel storage 15 Oil well/Gas well
 3 Watertight sewer lines 6 Seepage pit 9 Feedyard 12 Fertilizer storage 16 Other (specify below)
 13 Insecticide storage _____
 Direction from well? **Within Landfill** How many feet? _____

FROM	TO	LITHOLOGIC LOG	FROM	TO	PLUGGING INTERVALS
0	20	Silty clay			
20	39	Sandy clay			
39	50	Clayey silt			
50	85	Sandy clay			
85	110	Sand			

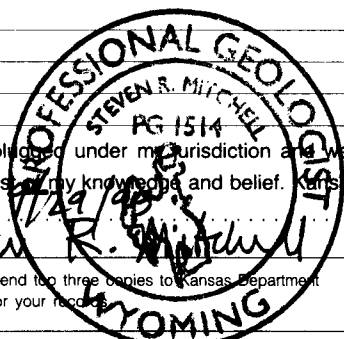7 CONTRACTOR'S OR LANDOWNERS CERTIFICATION: This water well was **1** constructed, **2** reconstructed, or **3** plugged under my jurisdiction and was completed on (mo/day/year) **9/9/93** and this record is true to the best of my knowledge and belief. Kansas Water Well Contractor's License No. **102** This Water Well Record was completed on (mo/day/yr) **9/9/93** under the business name of **Layne, Inc** by (signature) **Steven R. Mitchell**



OFFICE USE ONLY
T
R
EW
SEC.
1/4
1/4
1/4