USE TYPEWRITER OR BALL POINT PEN-PRESS FIRMLY, PRINT CLEARLY.

# WATER WELL RECORD
KSA 82a-1201-1215

Kansas Department of Health and Environment-Division of Environment
(Water well Contractors)
Topeka, Kansas 66620

| 1. Location of well: | County | Fraction | Section number | Township number | Range number |
|---|---|---|---|---|---|
| | Meade | NW 1/4 SE 1/4 SE 1/4 | 27 | T 31 S | R 28 E/W |

X 2. Distance and direction from nearest town or city:
Street address of well location if in city: 1½ N. Meade

3. Owner of well:
R.R. or street:
City, state, zip code: Harold Shore
Meade, Kansas 67864

4. Locate with "X" in section below:

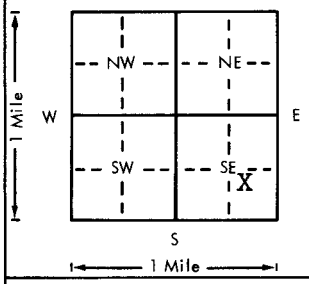


Sketch map:

6. Bore hole dia. 9 7/8 in. Completion date
Well depth 240 ft. 9-13-76

7. __ Cable tool X Rotary __ Driven __ Dug
__ Hollow rod __ Jetted __ Bored __ Reverse rotary

8. Use: X Domestic __ Public supply __ Industry
__ Irrigation __ Air conditioning __ Stock
__ Lawn __ Oil field water __ Other

9. Casing: Material PVC Height: Above or below
Threaded ____ Welded X Surface 12 in.
RMP ____ PVC ____ Weight 291 lbs./ft. 100
Dia. 5 in. to 240 ft. depth Wall Thickness: inches or
Dia. ____ in. to ____ ft. depth gage No. 265

| 5. Type and color of material | From | To |
|---|---|---|
| Top soil | 0 | 7 |
| Tan clay | 7 | 23 |
| Fine sand (some clay streaks) | 23 | 87 |
| Blue clay (drilled loose) | 87 | 210 |
| Blue clay (tight) | 210 | 220 |
| Blue clay & tan sandy clay (drilled loose) | 220 | 270 |
| | | |
| | | |
| | | |
| | | |
| | | |
| | | |
| | | |
| | | |
| (Use a second sheet if needed) | | |

10. Screen: Manufacturer's name
Jess & Lowell
Type PVC Dia. 5"
Slot/gauze 1/8" Length X 80'
Set between X 80 ft. and X 240 ft.
____ ft. and ____ ft.
Gravel pack? yes Size range of material 3/16"

11. Static water level: mo./day/yr.
82 ft. below land surface Date 9/8/76

12. Pumping level below land surfaces:
140 ft. after 12 hrs. pumping 12 g.p.m.
____ ft. after ____ hrs. pumping ____ g.p.m.
Estimated maximum yield ____ g.p.m.

13. Water sample submitted: mo./day/yr.
__ Yes X No Date

14. Well head completion:
X Pitless ~~adapter~~ unit ____ Inches above grade

X 15. Well grouted? ~~yes~~
With: ____ Neat cement ____ Bentonite X Concrete
Depth: From ____ ft. to ____ ft.

16. Nearest source of possible contamination:
ft. 50 Direction ~~west~~ Type ~~old well~~
Well disinfected upon completion? X Yes ____ No

17. Pump: ____ Not installed
Manufacturer's name Aermotor
Model number SD12 HP 1 Volts 220
Length of drop pipe 170 ft. capacity 10 g.p.m.
Type:
XX Submersible ____ Turbine
____ Jet ____ Reciprocating
____ Centrifugal ____ Other

18. Elevation:

Topography:
____ Hill
____ Slope
X Upland
____ Valley

19. Remarks:

20. Water well contractor's certification:
This well was drilled under my jurisdiction and this report is true to the best of my knowledge and belief.
Friesen Windmill 252
Business name License No.
Address ~~Meade, Kansas~~
Signed Harold Shore Date 9-28-76
Authorized representative

T 31 R 28 E/W Sec 27 1/4 1/4 1/4 NW SE SE

Forward the white, blue and pink copies to the Department of Health and Environment

Form WWC-5

MI-1023