


1 LOCATION OF WATER WELL: Fraction SW 1/4 SW 1/4 NE 1/4 Section Number 28 Township Number T 31 S Range Number R 28 EW
 County: Meade
 Distance and direction from nearest town or city street address of well if located within city?
 1 North, 1 West, 1/2 North, 1/4 West, 1/2 North, 1 West of Meade, Kansas

2 WATER WELL OWNER: Rains & Williamson Oil
 RR#, St. Address, Box #: Page Court, 220 W. Douglas Board of Agriculture, Division of Water Resources
 City, State, ZIP Code: Wichita, Kansas 67202 Application Number: ---

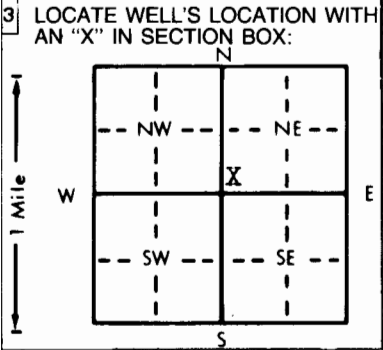

4 DEPTH OF COMPLETED WELL: 300 ft. ELEVATION: Hill
 Depth(s) Groundwater Encountered 1. 120 ft. 2. 220 ft. 3. ft.
 WELL'S STATIC WATER LEVEL: 90 ft. below land surface measured on mo/day/yr Mar. 31, 1983
 Pump test data: Well water was ft. after hours pumping gpm
 Est. Yield: 90 gpm; Well water was ft. after hours pumping gpm
 Bore Hole Diameter: 9 7/8 in. to 300 ft., and in. to ft.
 WELL WATER TO BE USED AS:
 1 Domestic 3 Feedlot XX Oil field water supply 9 Dewatering 12 Other (Specify below)
 2 Irrigation 4 Industrial 7 Lawn and garden only 10 Observation well
 Was a chemical/bacteriological sample submitted to Department? Yes No XX; If yes, mo/day/yr sample was submitted
 Water Well Disinfected? Yes XX No

5 TYPE OF BLANK CASING USED:
 1 Steel 3 RMP (SR) 5 Wrought iron 8 Concrete tile CASING JOINTS: Glued XX Clamped
 XX PVC 4 ABS 6 Asbestos-Cement 9 Other (specify below) Welded
 7 Fiberglass Threaded
 Blank casing diameter: 5 in. to 220 ft., Dia 240 in. to 280 ft., Dia ft.
 Casing height above land surface: 12 in., weight 2.8 lbs./ft. Wall thickness or gauge No. 265
 TYPE OF SCREEN OR PERFORATION MATERIAL:
 1 Steel 3 Stainless steel 5 Fiberglass 8 RMP (SR) 10 Asbestos-cement
 2 Brass 4 Galvanized steel 6 Concrete tile 9 ABS 11 Other (specify)
 12 None used (open hole)
 SCREEN OR PERFORATION OPENINGS ARE:
 1 Continuous slot 3 Mill slot 5 Gauzed wrapped XX Saw cut 11 None (open hole)
 2 Louvered shutter 4 Key punched 6 Wire wrapped 9 Drilled holes
 7 Torch cut 10 Other (specify)
 SCREEN-PERFORATED INTERVALS: From 220 ft. to 240 ft., From ft. to ft.
 From 280 ft. to 300 ft., From ft. to ft.
 GRAVEL PACK INTERVALS: From 14 ft. to 300 ft., From ft. to ft.
 From ft. to ft.

6 GROUT MATERIAL: XX Neat cement 2 Cement grout 3 Bentonite 4 Other
 Grout Intervals: From 4 ft. to 14 ft., From ft. to ft.
 What is the nearest source of possible contamination:
 1 Septic tank 4 Lateral lines 7 Pit privy 10 Livestock pens 14 Abandoned water well
 2 Sewer lines 5 Cess pool 8 Sewage lagoon 11 Fuel storage XX Oil well/Gas well
 3 Watertight sewer lines 6 Seepage pit 9 Feedyard 12 Fertilizer storage 16 Other (specify below)
 13 Insecticide storage
 Direction from well? Southwest How many feet? 75

FROM	TO	LITHOLOGIC LOG	FROM	TO	LITHOLOGIC LOG
0	1	Topsoil	01		
1	25	Sandy Clay	04		
25	50	Fine Sand w/Clay Streaks	07		
50	55	Clay	01		
55	70	Fine Sand	07		
70	120	Loose Clay w/Layer of Sand	04		
120	220	Fine to Med. Sand	05		
220	285	Fine Sand	07		
285	300	Black Shale	19		

7 CONTRACTOR'S OR LANDOWNER'S CERTIFICATION: This water well was (1) constructed, (2) reconstructed, or (3) plugged under my jurisdiction and was completed on (mo/day/year) ... March 31, 1983 ... and this record is true to the best of my knowledge and belief. Kansas Water Well Contractor's License No. ... 252 ... This Water Well Record was completed on (mo/day/year) ... April 6, 1983 ... under the business name of Friesen Windmill & Supply Inc. by (signature)

INSTRUCTIONS: Use typewriter or ball point pen, PLEASE PRESS FIRMLY and PRINT clearly. Please fill in blanks, underline or circle the correct answers. Send top three copies to Kansas Department of Health and Environment, Division of Environment, Environmental Geology Section, Topeka, KS 66620. Send one to WATER WELL OWNER and retain one for your records.

OFFICE USE ONLY
T
3/1
R
28
EW
SEC.
28
SW 1/4
SW 1/4
NE 1/4